


Township N^o 11 N, Range N^o 3 West, 4th Mer. *Revised with Sur. Kent's letter of the 26 March 1844.*

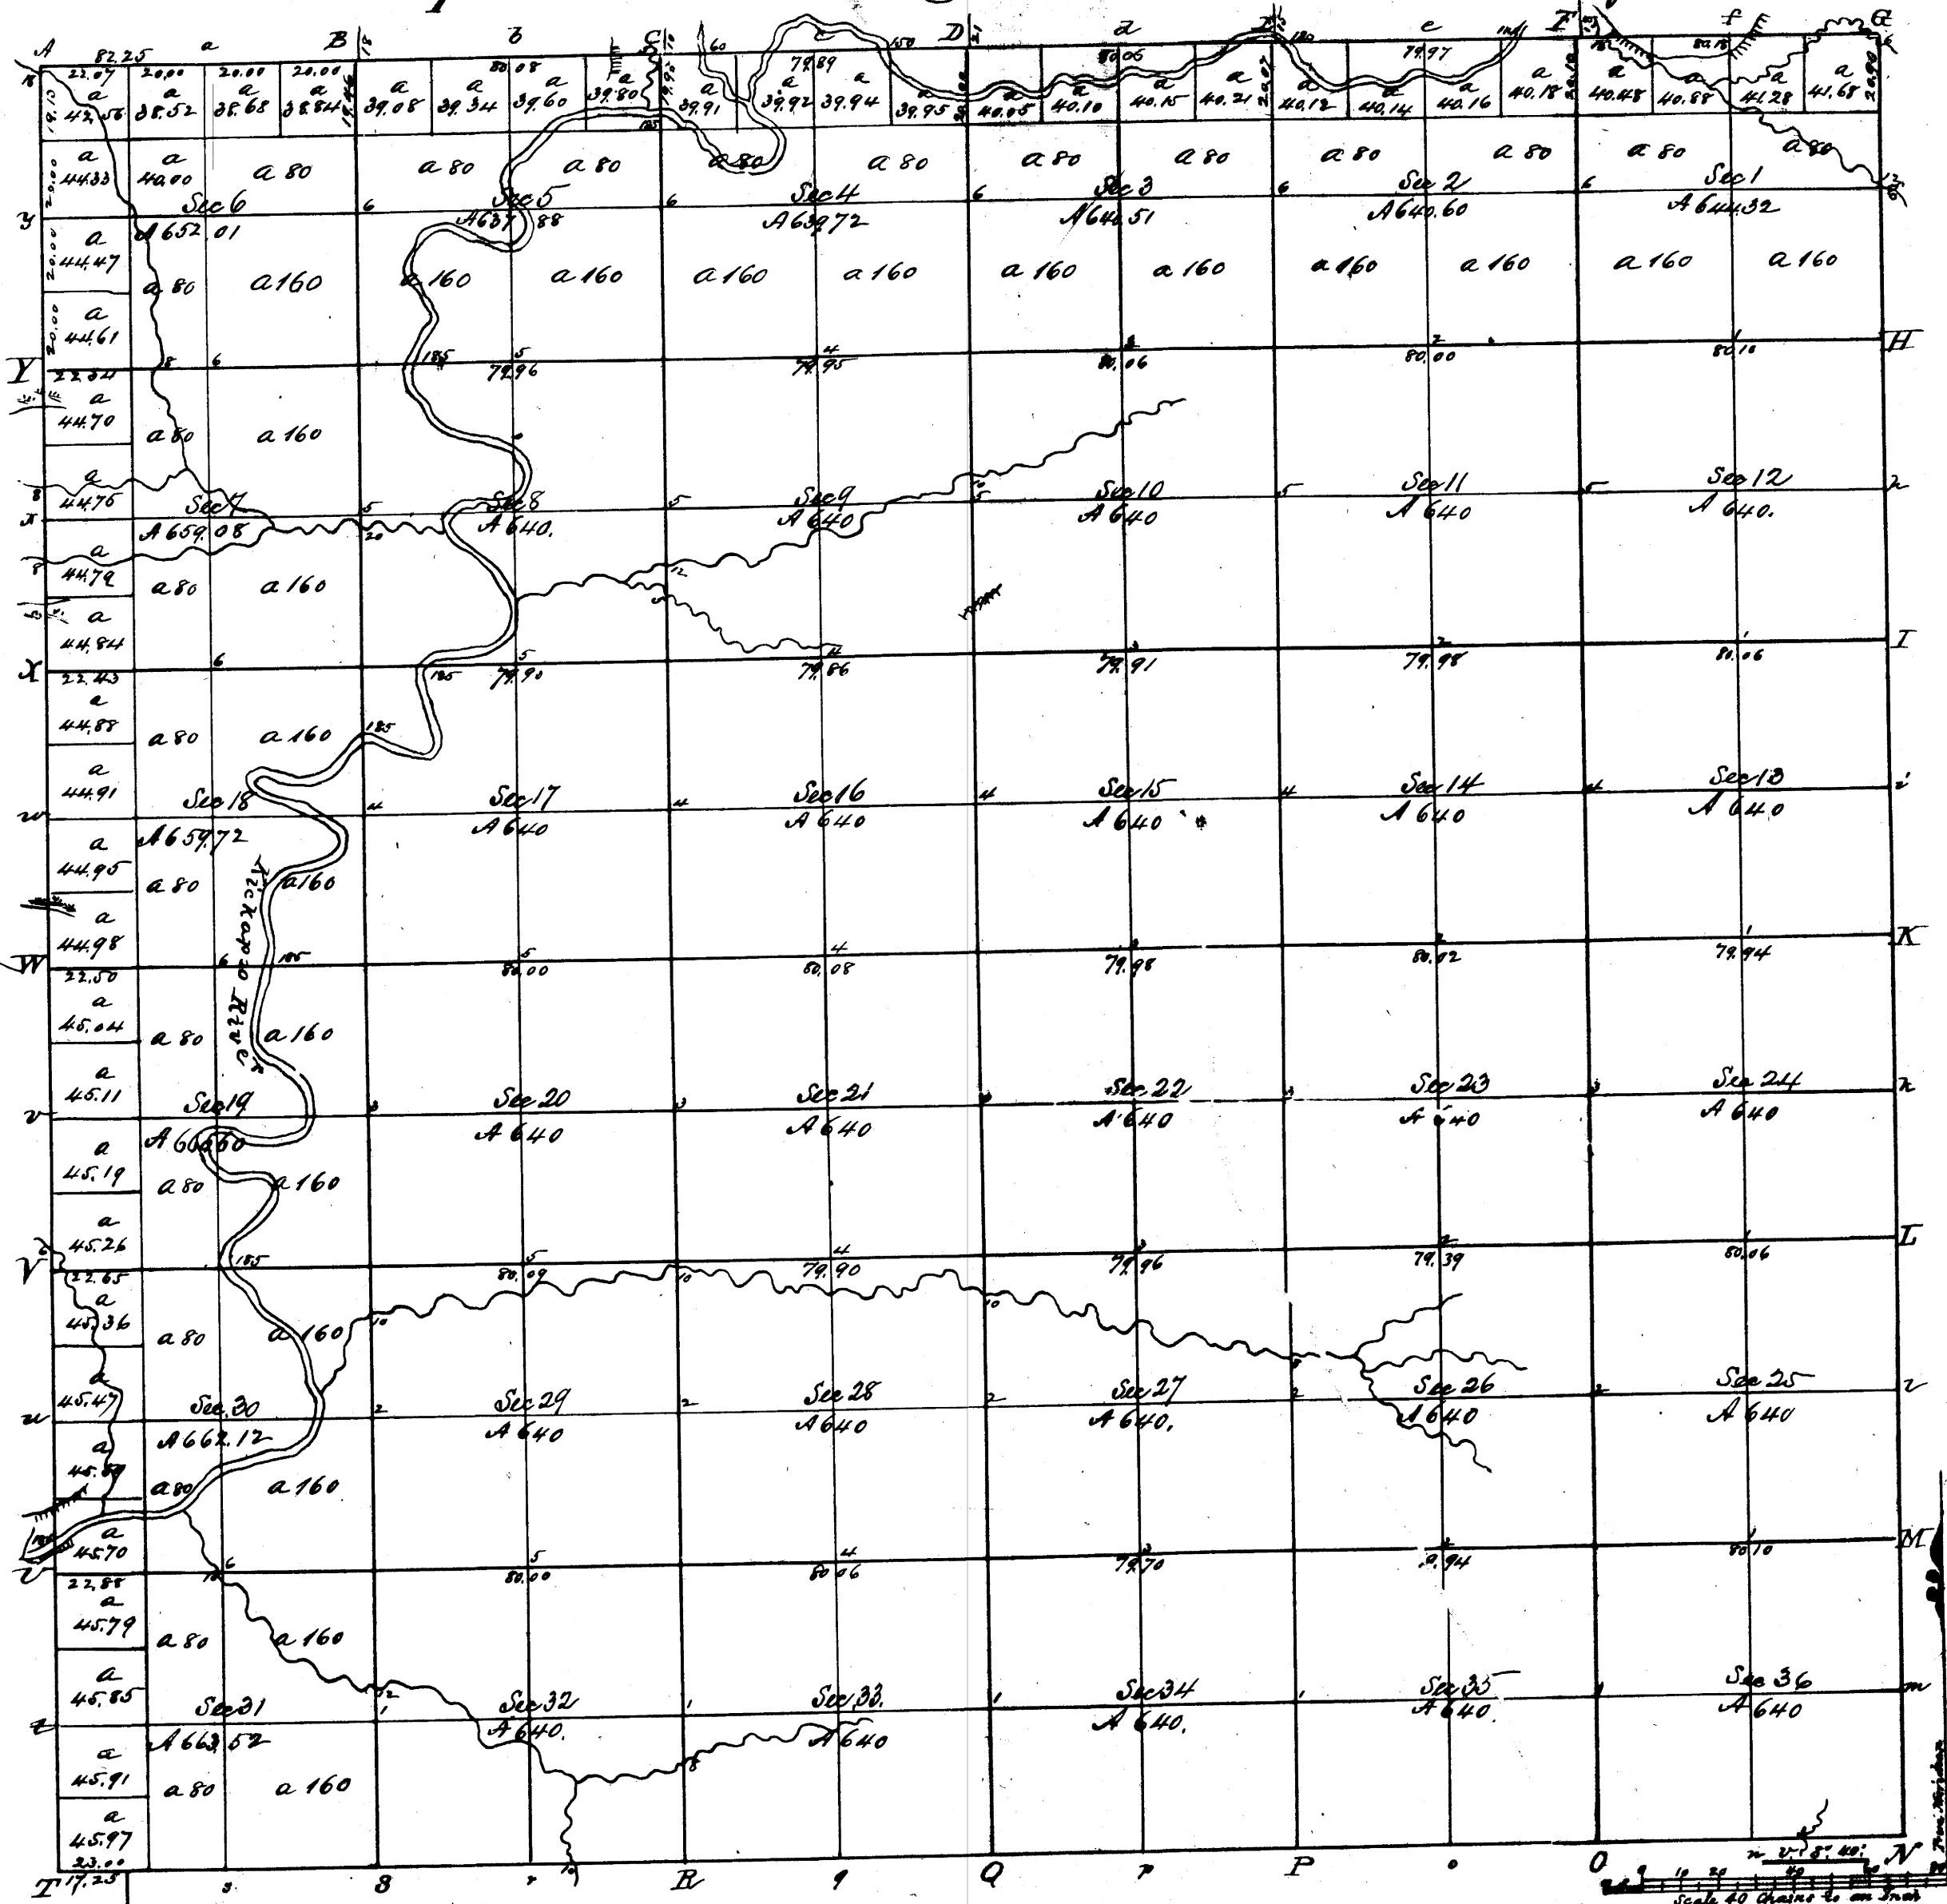

Total number of Acres 23,160.08

Surveys Designated	By Whom Surveyed	Date of Contract	Amount of Surveys	When Surveyed	When for and at what time the Sur. Gen. was
Township lines	Wm A Burt	Oct 24 1839	24.05.28	1st of 1840	1st of 1841
Subdivisions	H Baunro	May 20 1843	60.12.41	3d of 1843	1st of 1844

The above Map of Township N^o 11 North of Range N^o 3 West 4th Principal Meridian in Wisconsin Territory is strictly conformable to the field notes of the survey of a file in this Office which have been examined and approved by the Surveyor General's Office
 Done at Dubuque Mo. Feb 21 1844
 James M. [Signature]