


Recd with the Sur. Genl. letter of the 22nd March 1844.

Township N^o 11 N, Range N^o 4 West, 4th Mer.

* See plat with S.G. letter of 22nd March 1845.

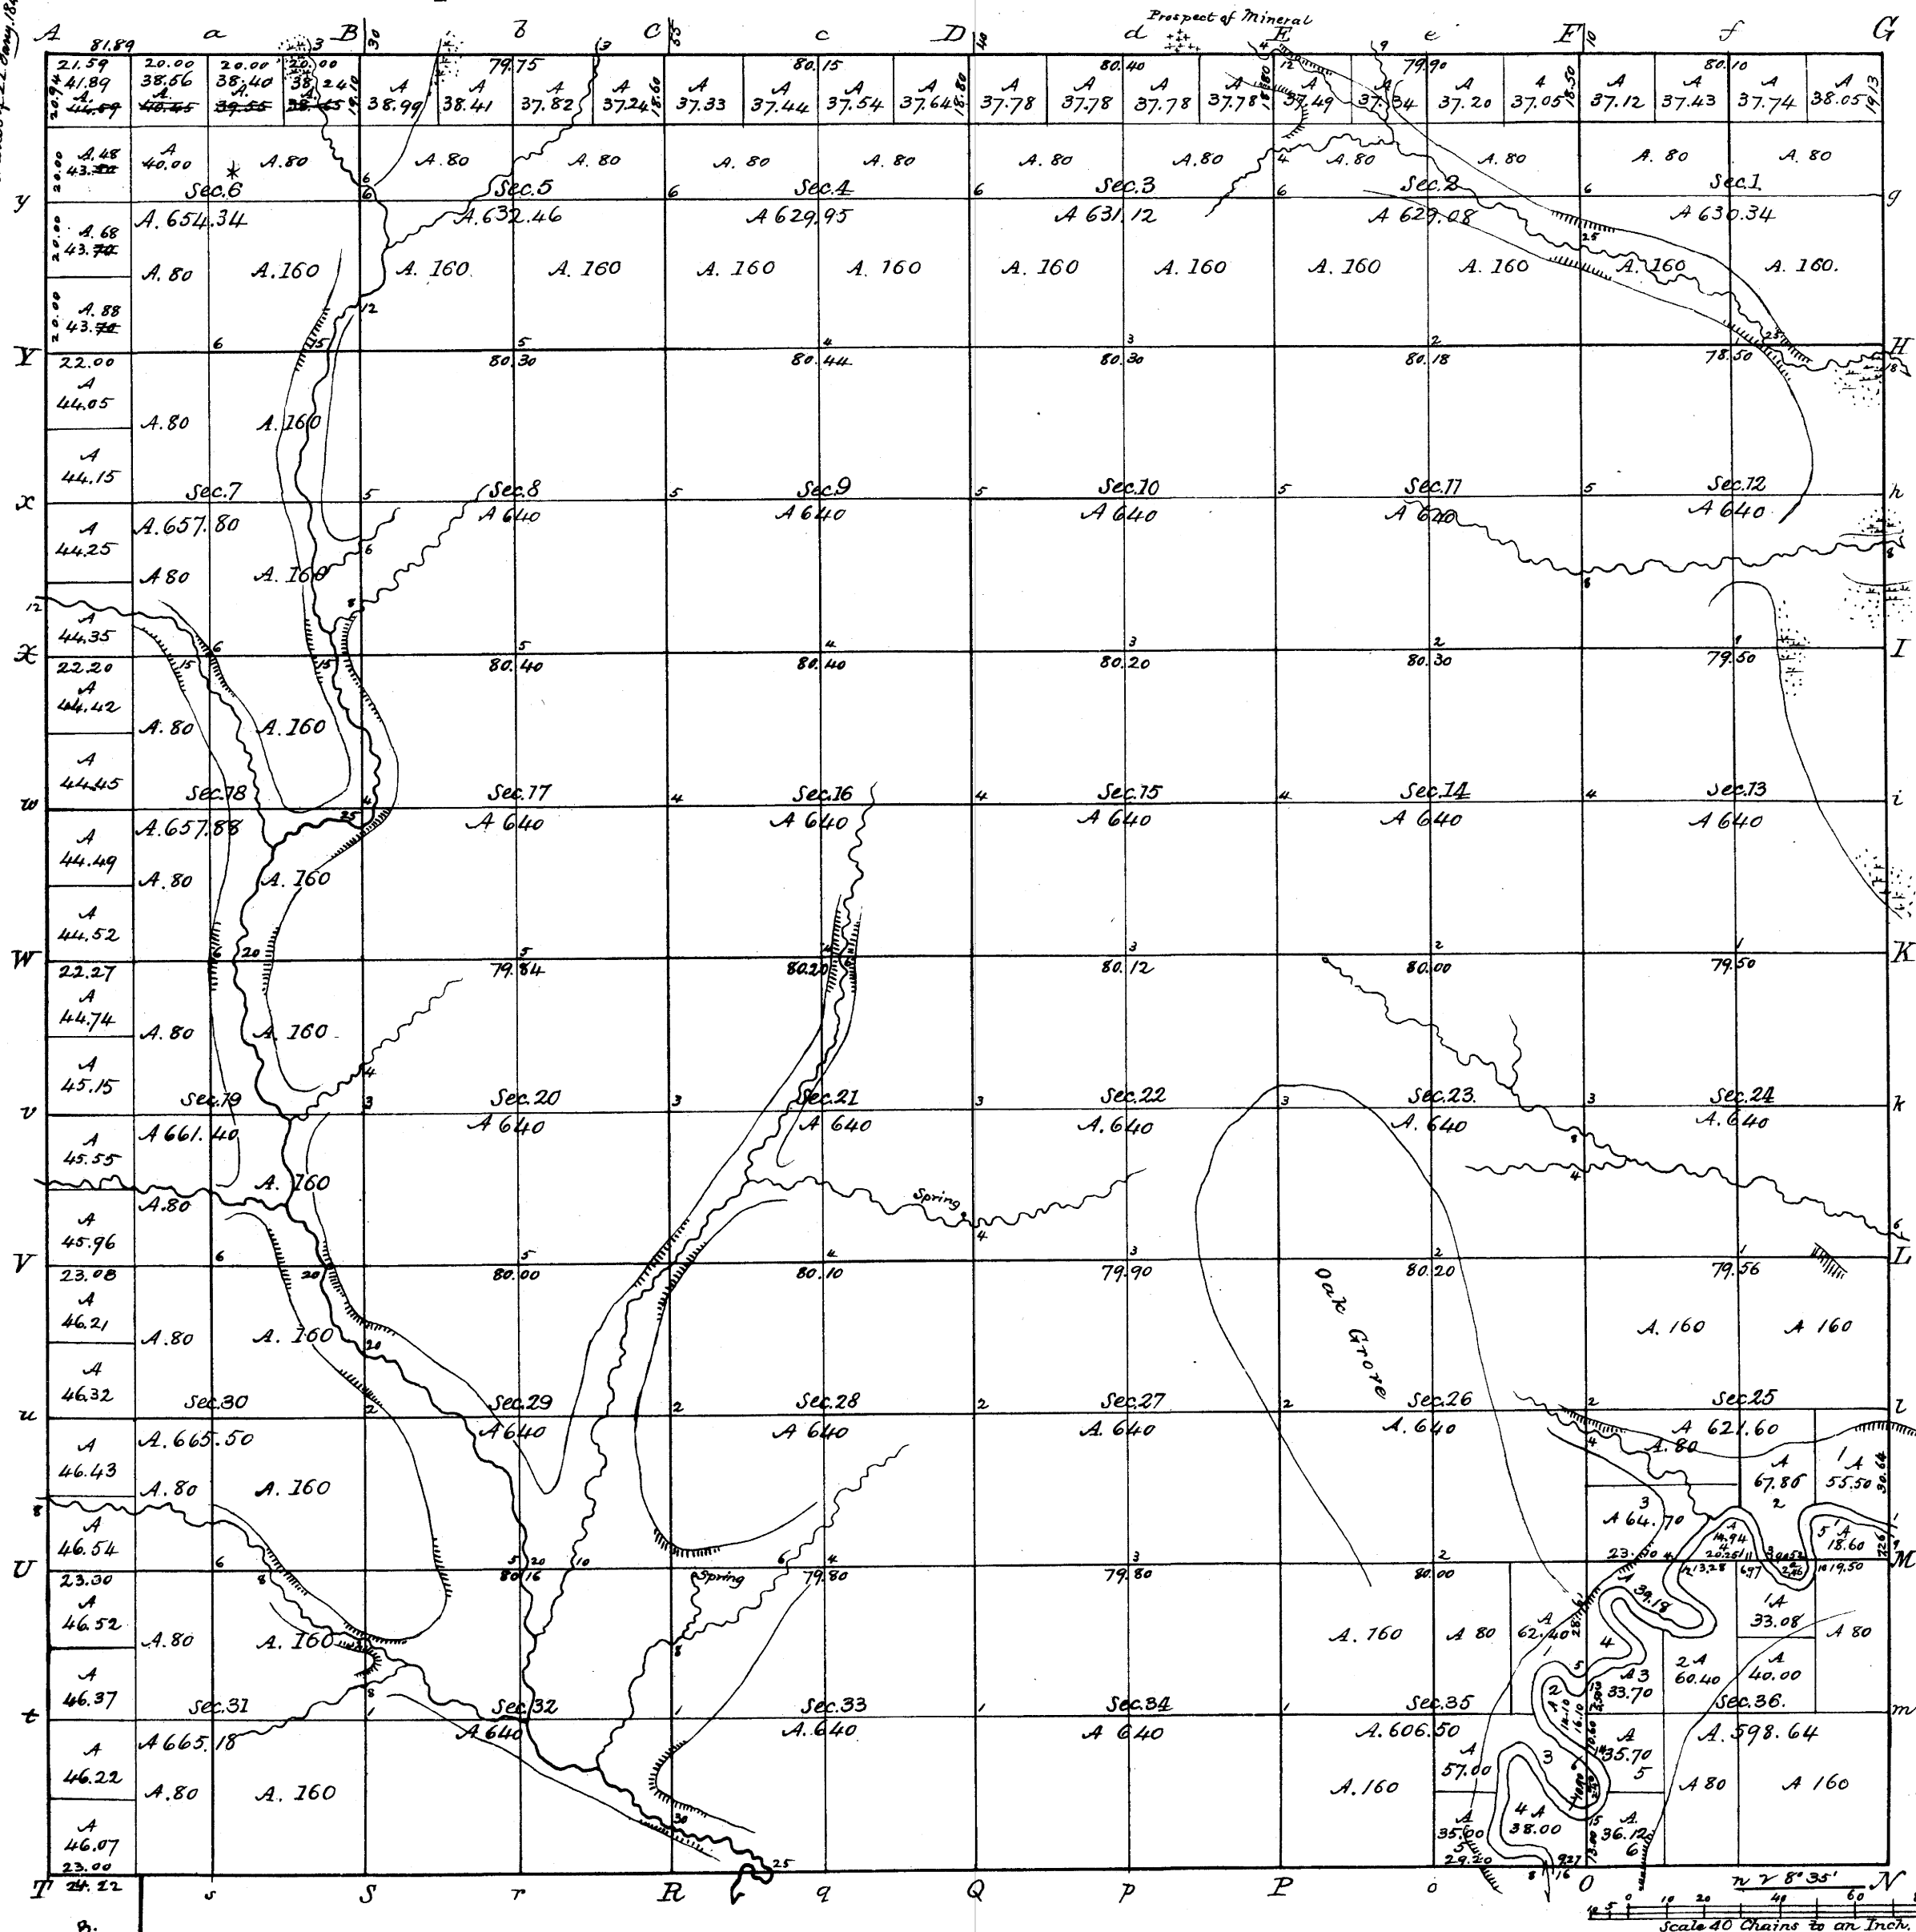

V.33 B.

Total number of Acres. 23,021.79

Surveys Designated	By Whom Surveyed	Date of Contract	Amount of Surveys	When Surveyed	When p ^d for and ch ^d in the Sur. Genl. acc ^t
Township lines	Wm A. Burt	Oct. 24, 1839	M. Ch ^s 24. 04. 96	1 st q ^r 1840	1 st q ^r 1841
Subdivisions	Saml C. Wittin	May 23, 1843	64. 13. 97	3 rd q ^r 1843	4 th q ^r 1843

The above Map of Township N^o 11 North of Range N^o 4 West, 4th Principal Meridian Wisconsin Territory, is strictly conformable to the field notes of the survey thereof on file in this Office which have been examined and approved.

Surveyor General's Office,
Dubuque, December 7, 1843.

James Wilson
Sur. Genl.