


Township N^o 11 N, Range N^o 5 West, 4th Mer.

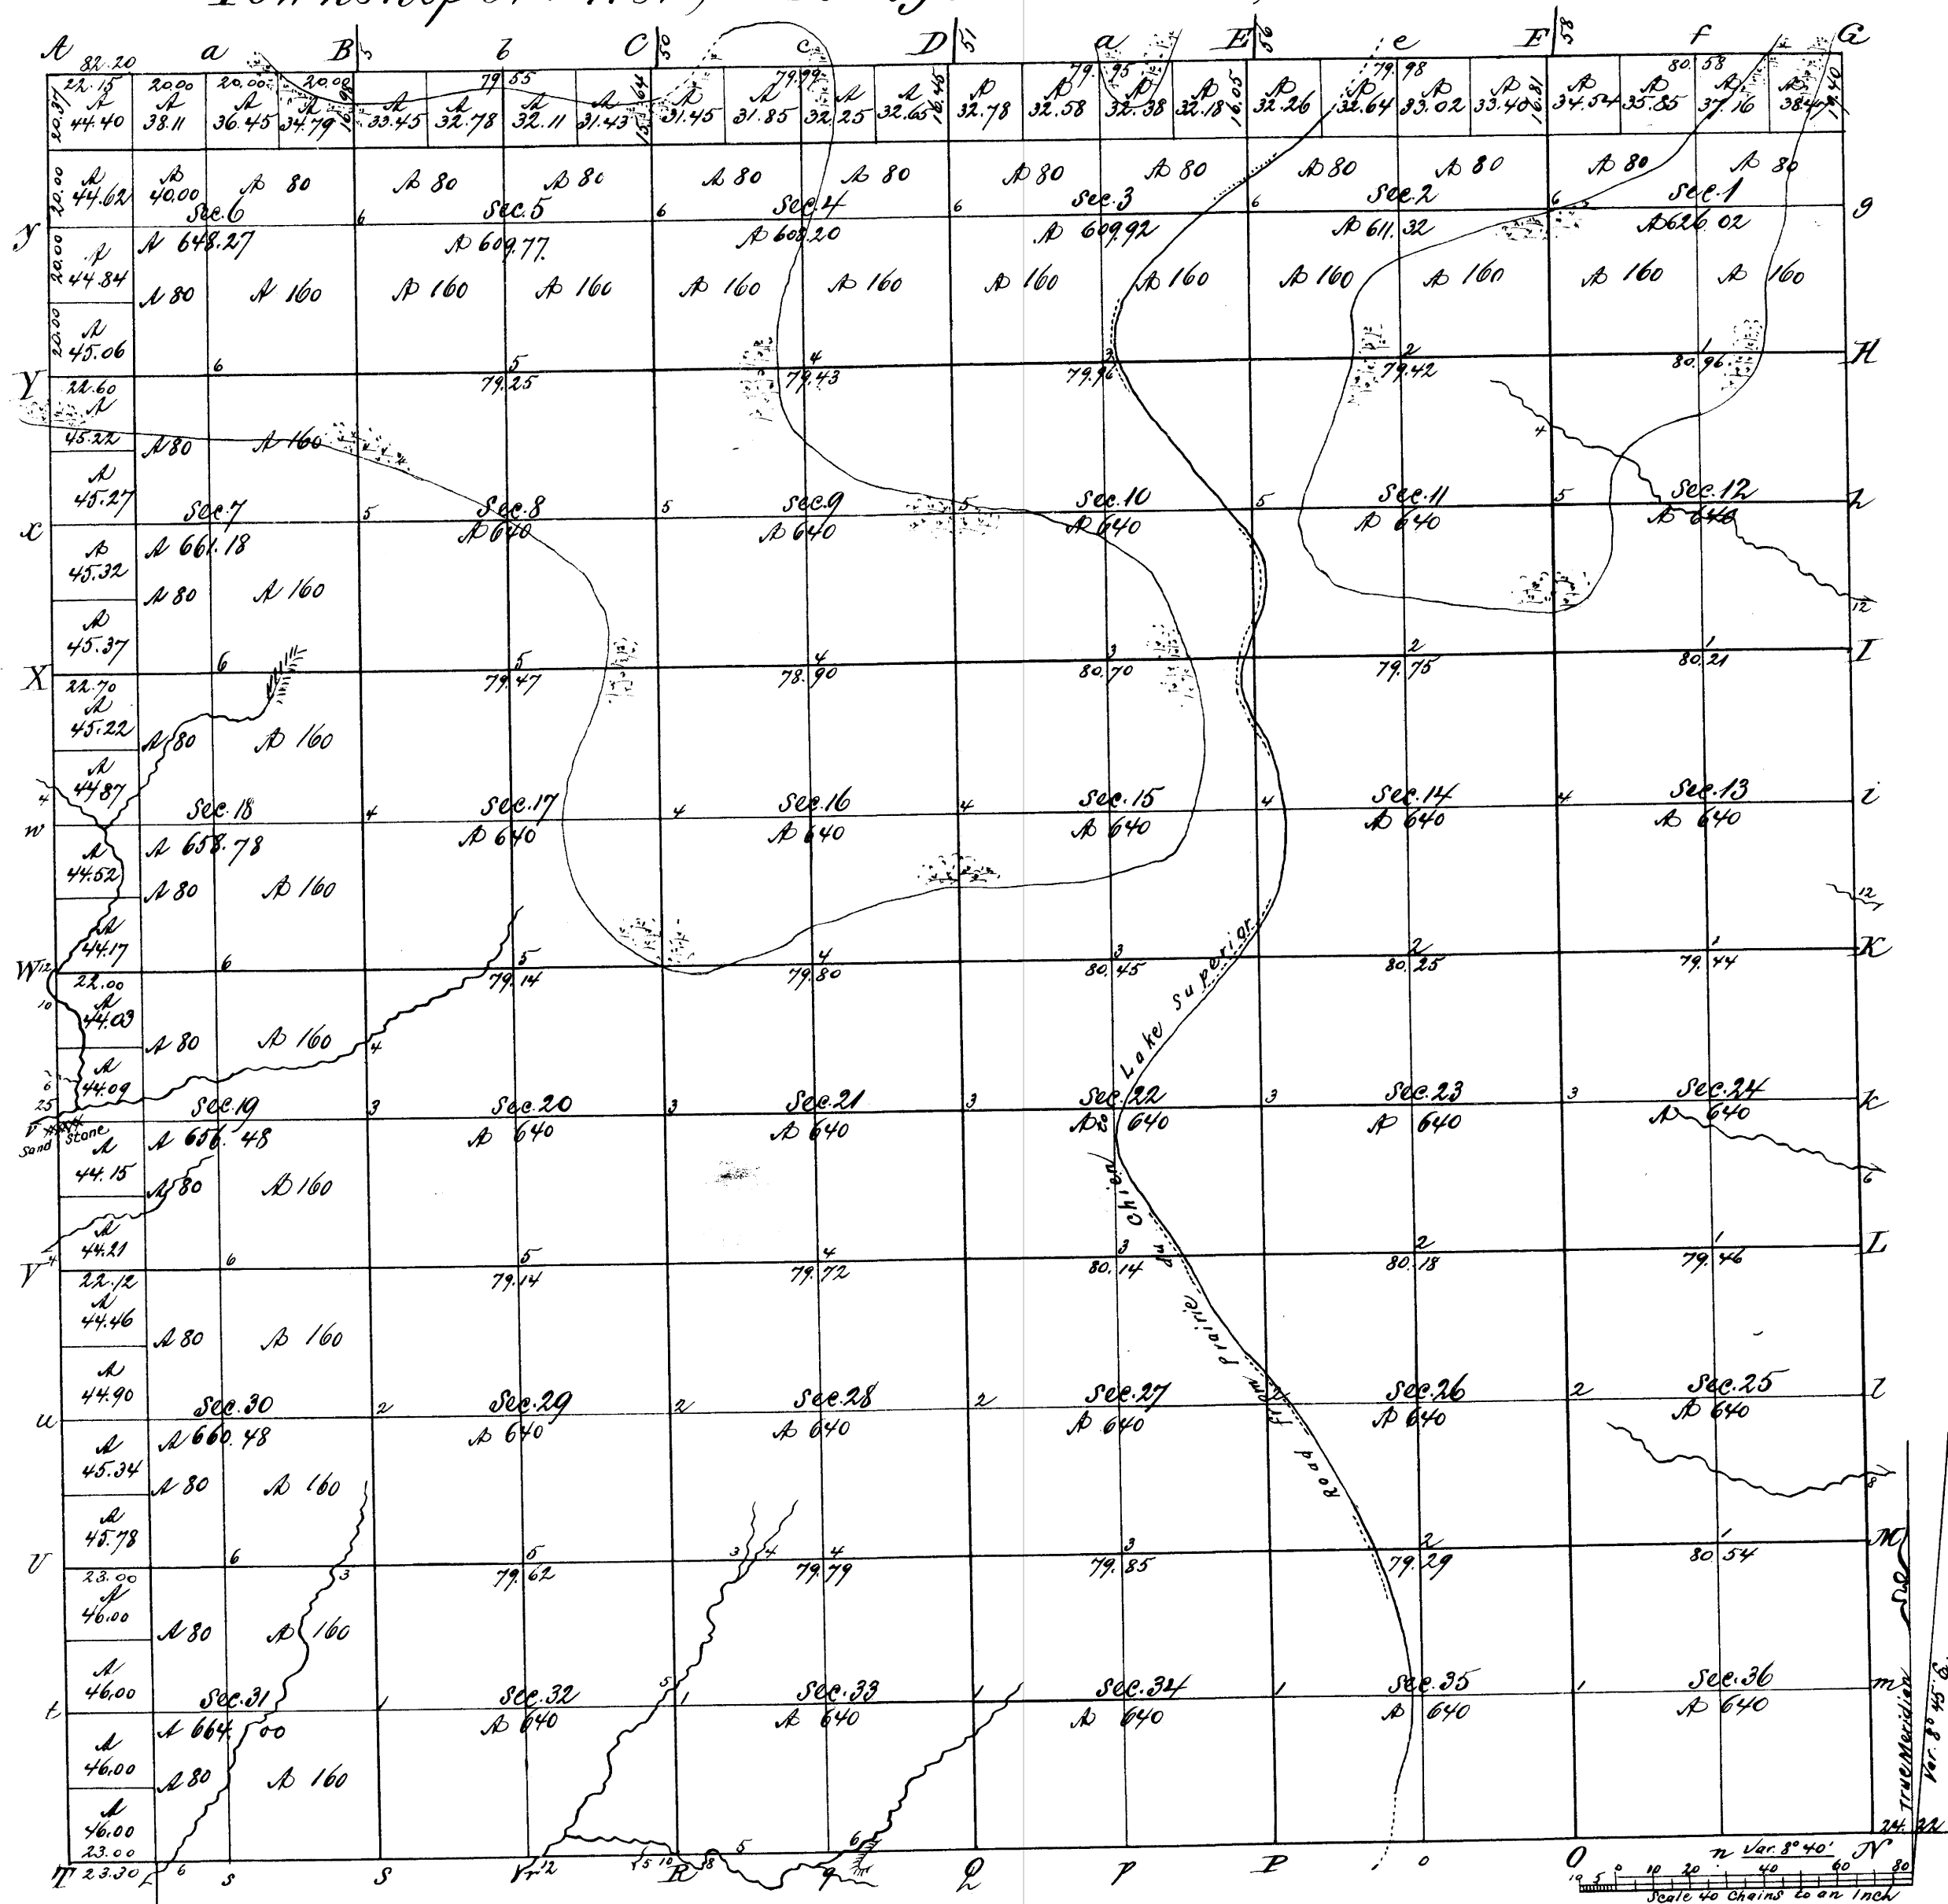

*Recd with the Sur. Genl.
of the 11th March 1844*

Vol. 33. B.

Total number of Acres: 23,014.42

Surveys Designated	By Whom Surveyed	Date of Contract	Amount of Surveys	When Surveyed	When p ^d for and ch ^d in the Sur. Genl's acct
Township lines	Wm. A. Beut	Oct. 24. 1839	M. Ch ³ L ⁴⁸ 24,041.97	1 st q ^r 1840	1 st q ^r 1841
Subdivisions	A. L. Heaven	May 23. 1843	89,74.35	3 rd q ^r 1843	4 th q ^r 1843

The above Map of Township N^o 11 North, of Range N^o 5 West 4th Principal Meridian Wisconsin Territory, is strictly conformable to the field notes of the survey thereof on file in this Office, which have been examined and approved.

Surveyor General's Office } James Wilson
Dubuque, Dec. 27. 1843 } Sur. Genl.