


Township No 13 N. Range No 3 West 4th Mer. Rec^d with S.G. letter of 22 Sept. 1845

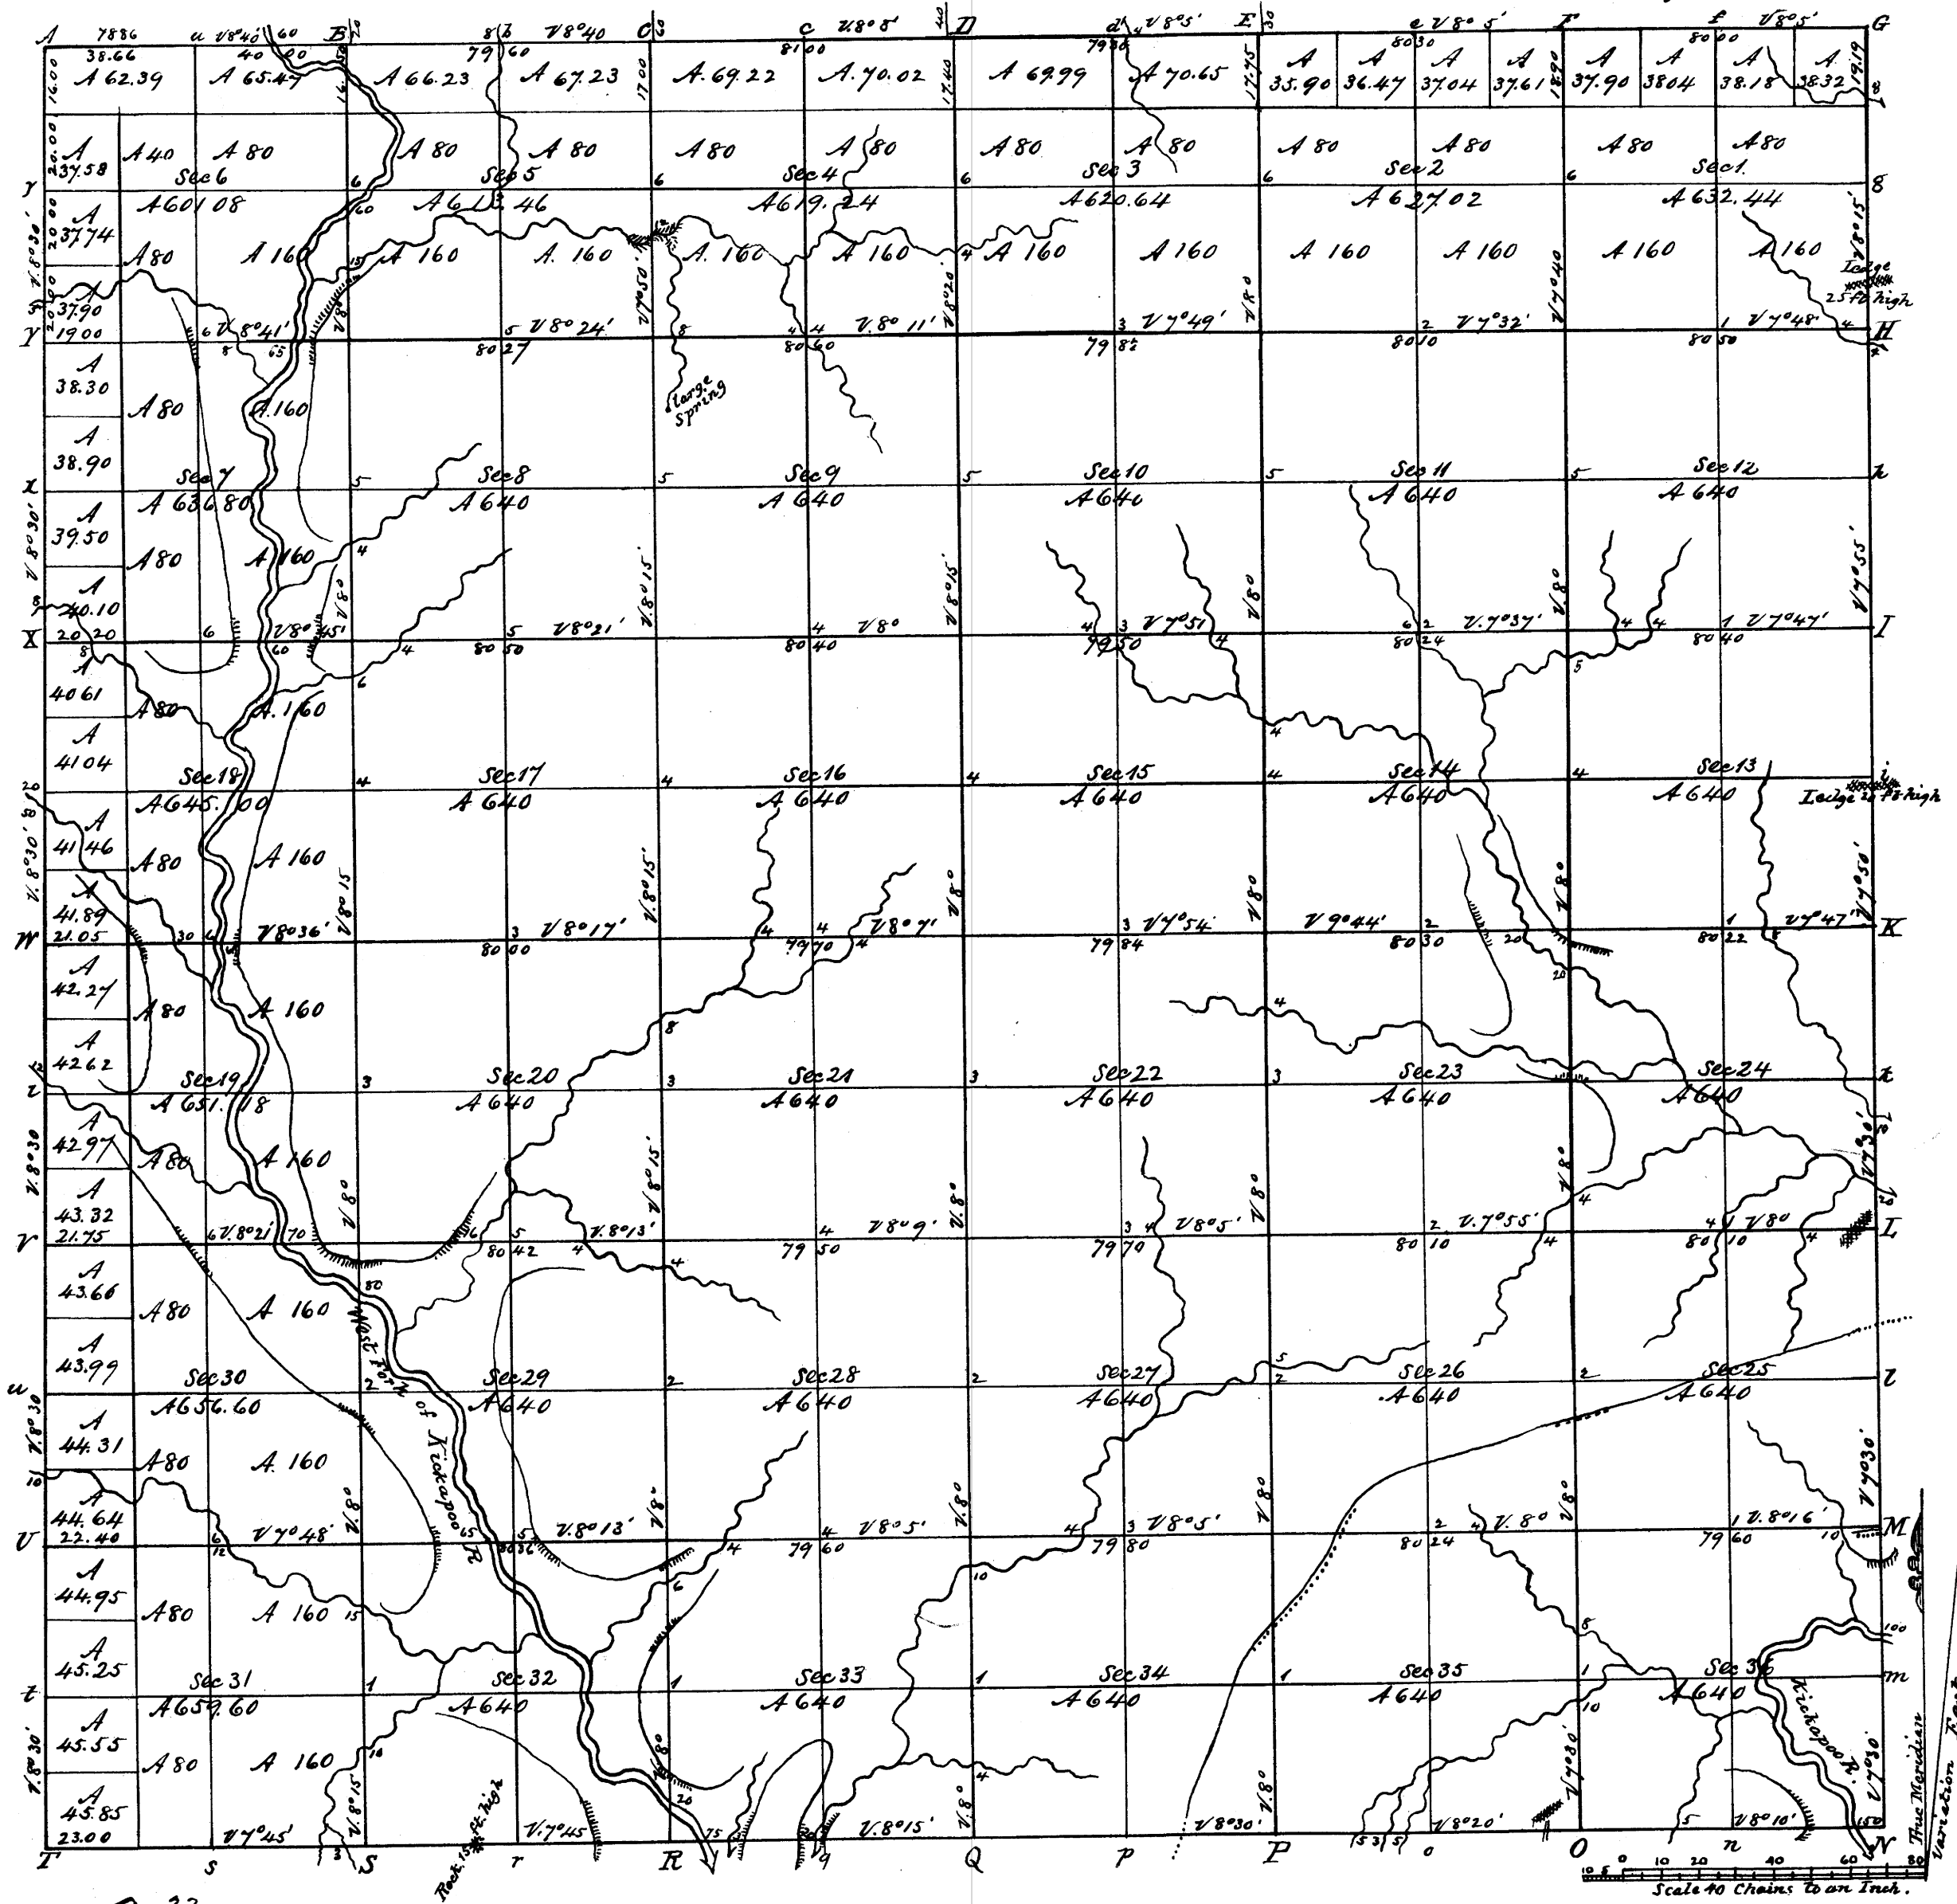

a 33-

Total number of Acres. 22,963.06

Surveys Designated	By Whom Surveyed	Date of Contract	Amount of Surveys	When Surveyed	Whom for and what on the Sur ^r Gen ^l 's acct
Township lines	J. G. Whitaker	November 2 ^d 1844	M. Ch ^s Lks 23.. 77.. 05	Nov. 1844	Wm. T. H. Mearns
Subdivisions	Saml D. Dixon	May 15. 1845	59. 71. 95	June. 1845	

The above Map, of Township No 13 North, of Range No 3 West of the 4th Principal Meridian Wisconsin Territory, is strictly conformable to the field notes of the survey thereof, on file in this Office, which have been examined, and approved

Surveyor General's Office
 Dubuque, September 18. 1845

Geo. Jones Sur^r Gen^l