


Township N^o 13 N., Range N^o 4 West 4th Mer.

Rec^d with P. O. letter of 22 Sept. 1845

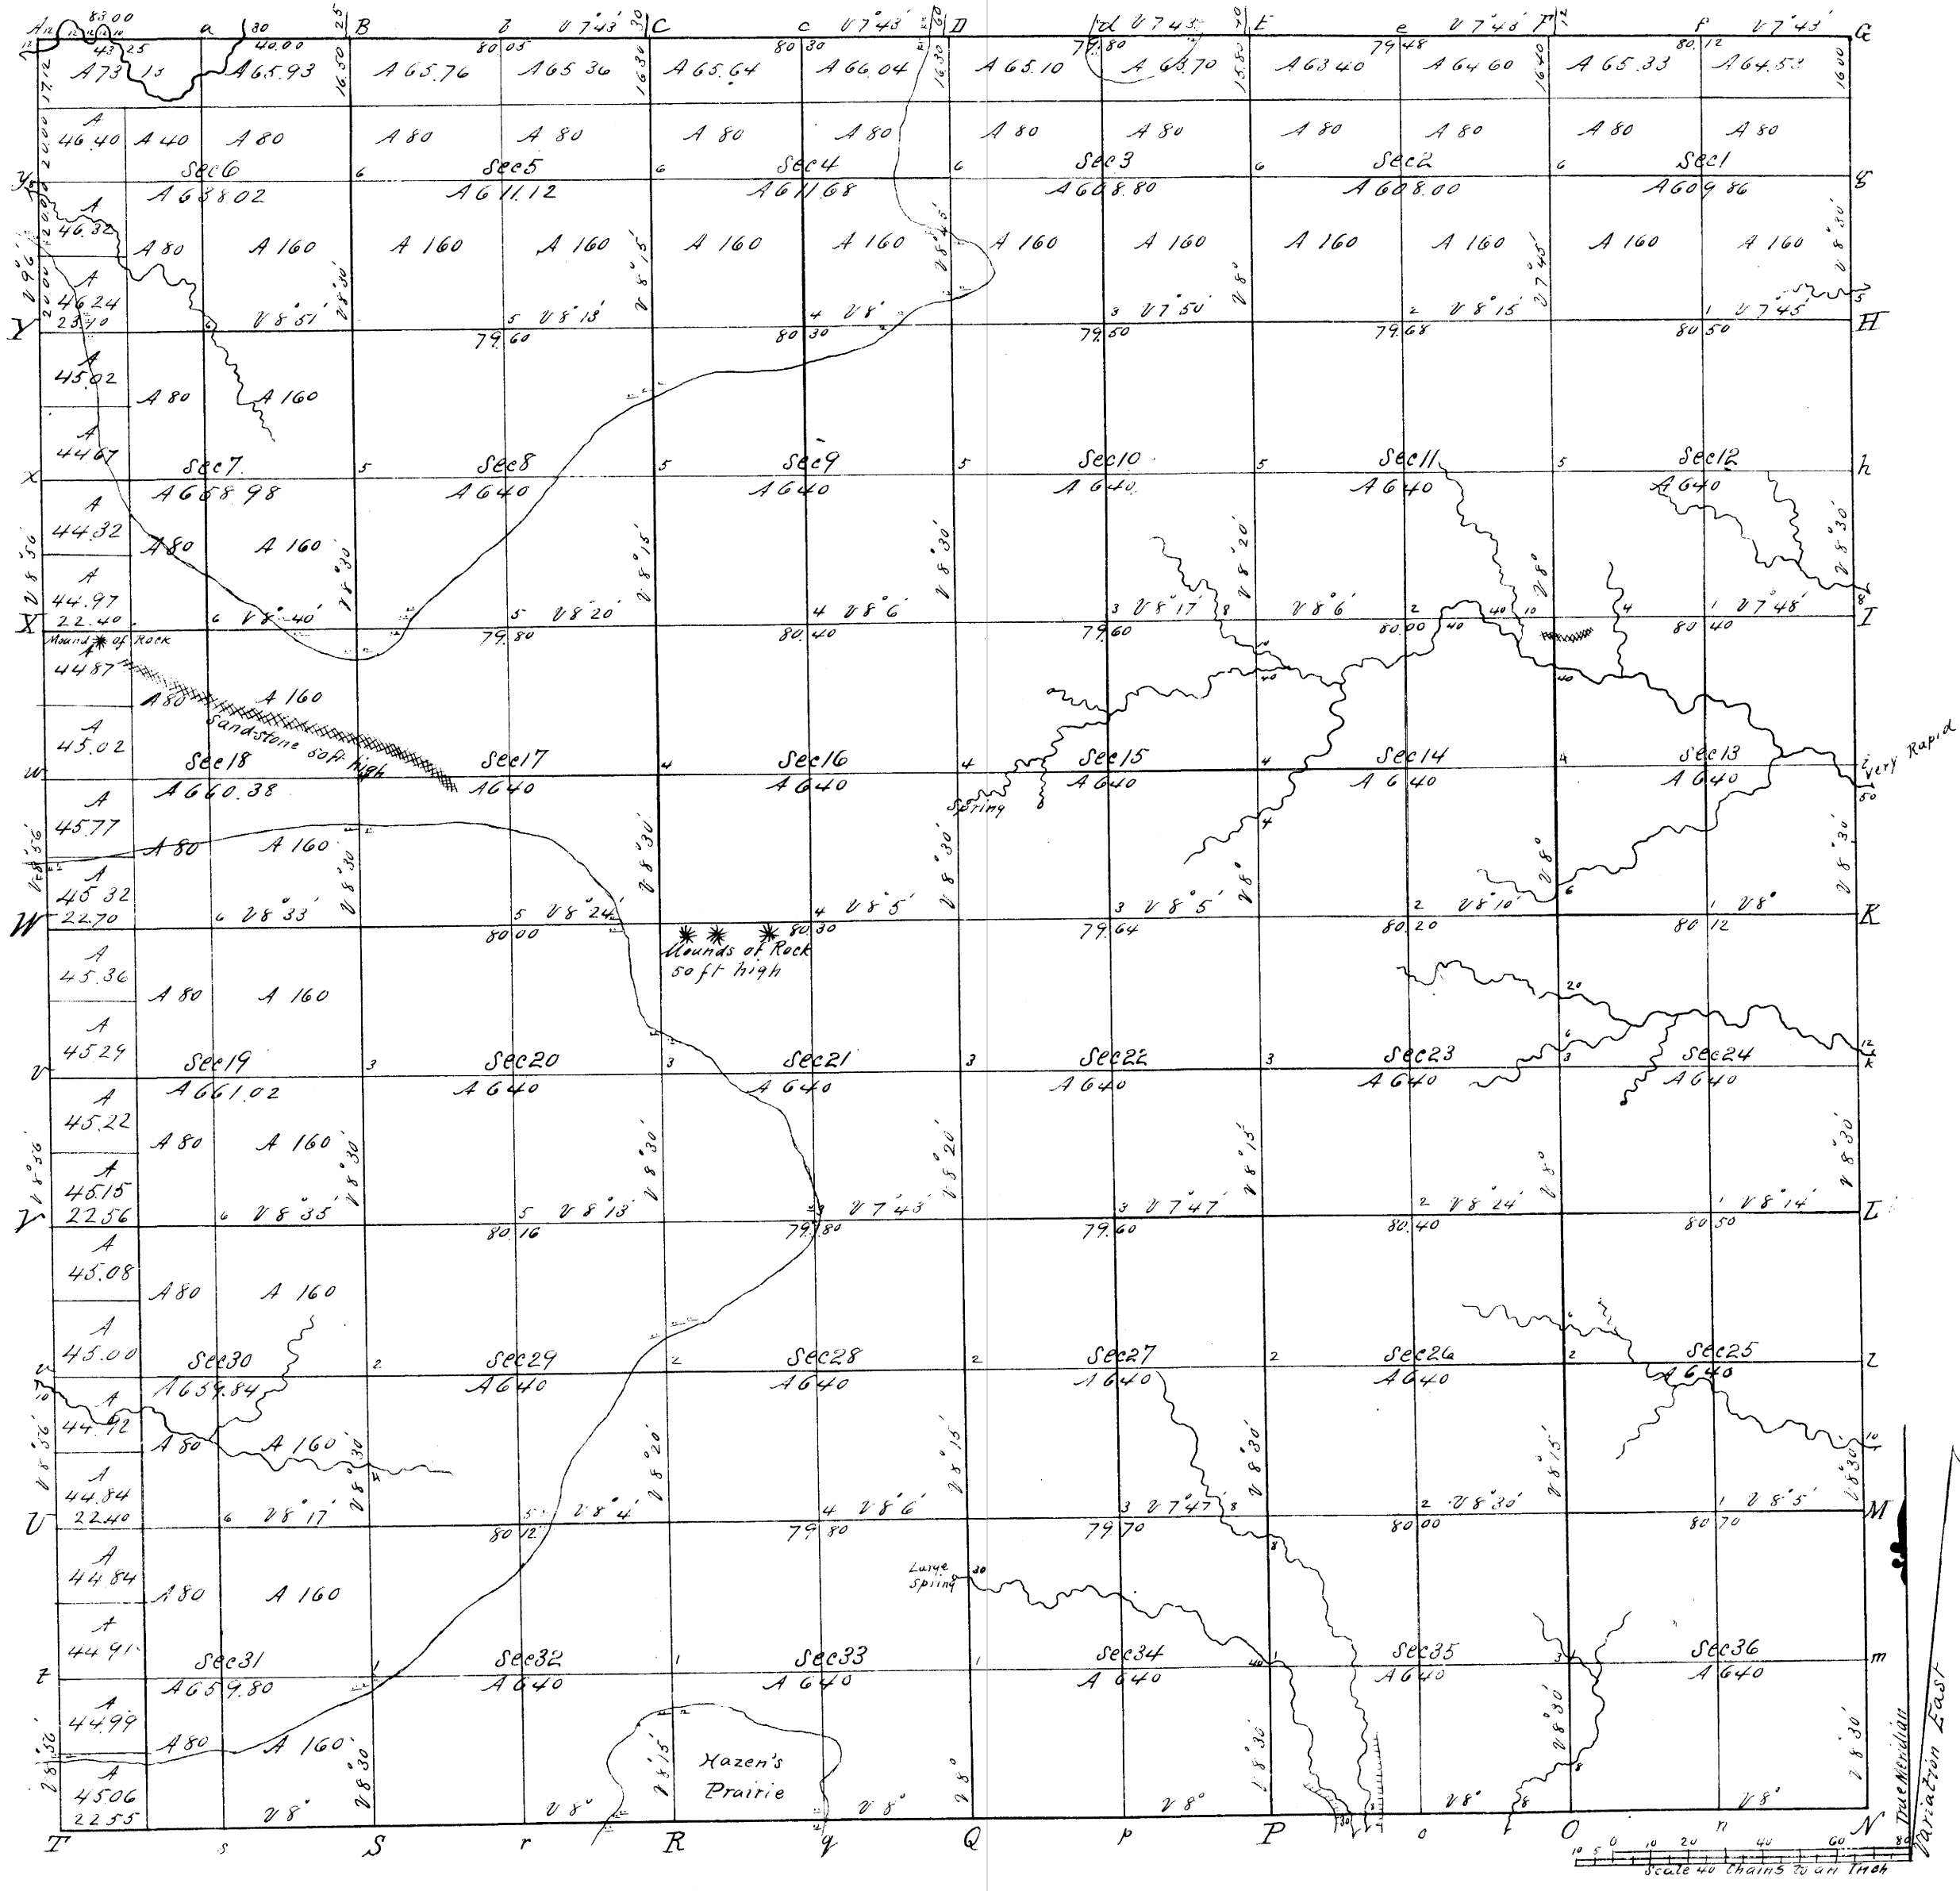

Total number of Acres 22 987.50

Surveys Designated	By Whom Surveyed	Date of Contract	Amount of Surveys	When Surveyed	When paid for and in ^o in the part of the acct
Township lines	J. E. Whitcher	November 2 1844	M. Chs Lks 23. 78. 67	November 28 1844	
Subdivisions	Saml. D. Dixon	May 15. 1845	59. 74. 66	June & July. 1845	

The above Map of Township N^o 13 North of Range N^o 4 West 4th Principal Meridian Wisconsin Territory is strictly conformable to the field notes of the survey thereof on file in this Office which have been examined and approved.

Surveyor General's Office } Geo. W. Jones Sur^r Genl.
Doboyne September 18 1845