


Township N^o 13 N, Range N^o 5 West 4th Mer.
 Rect with S^y letter of 22 Sept 1845.

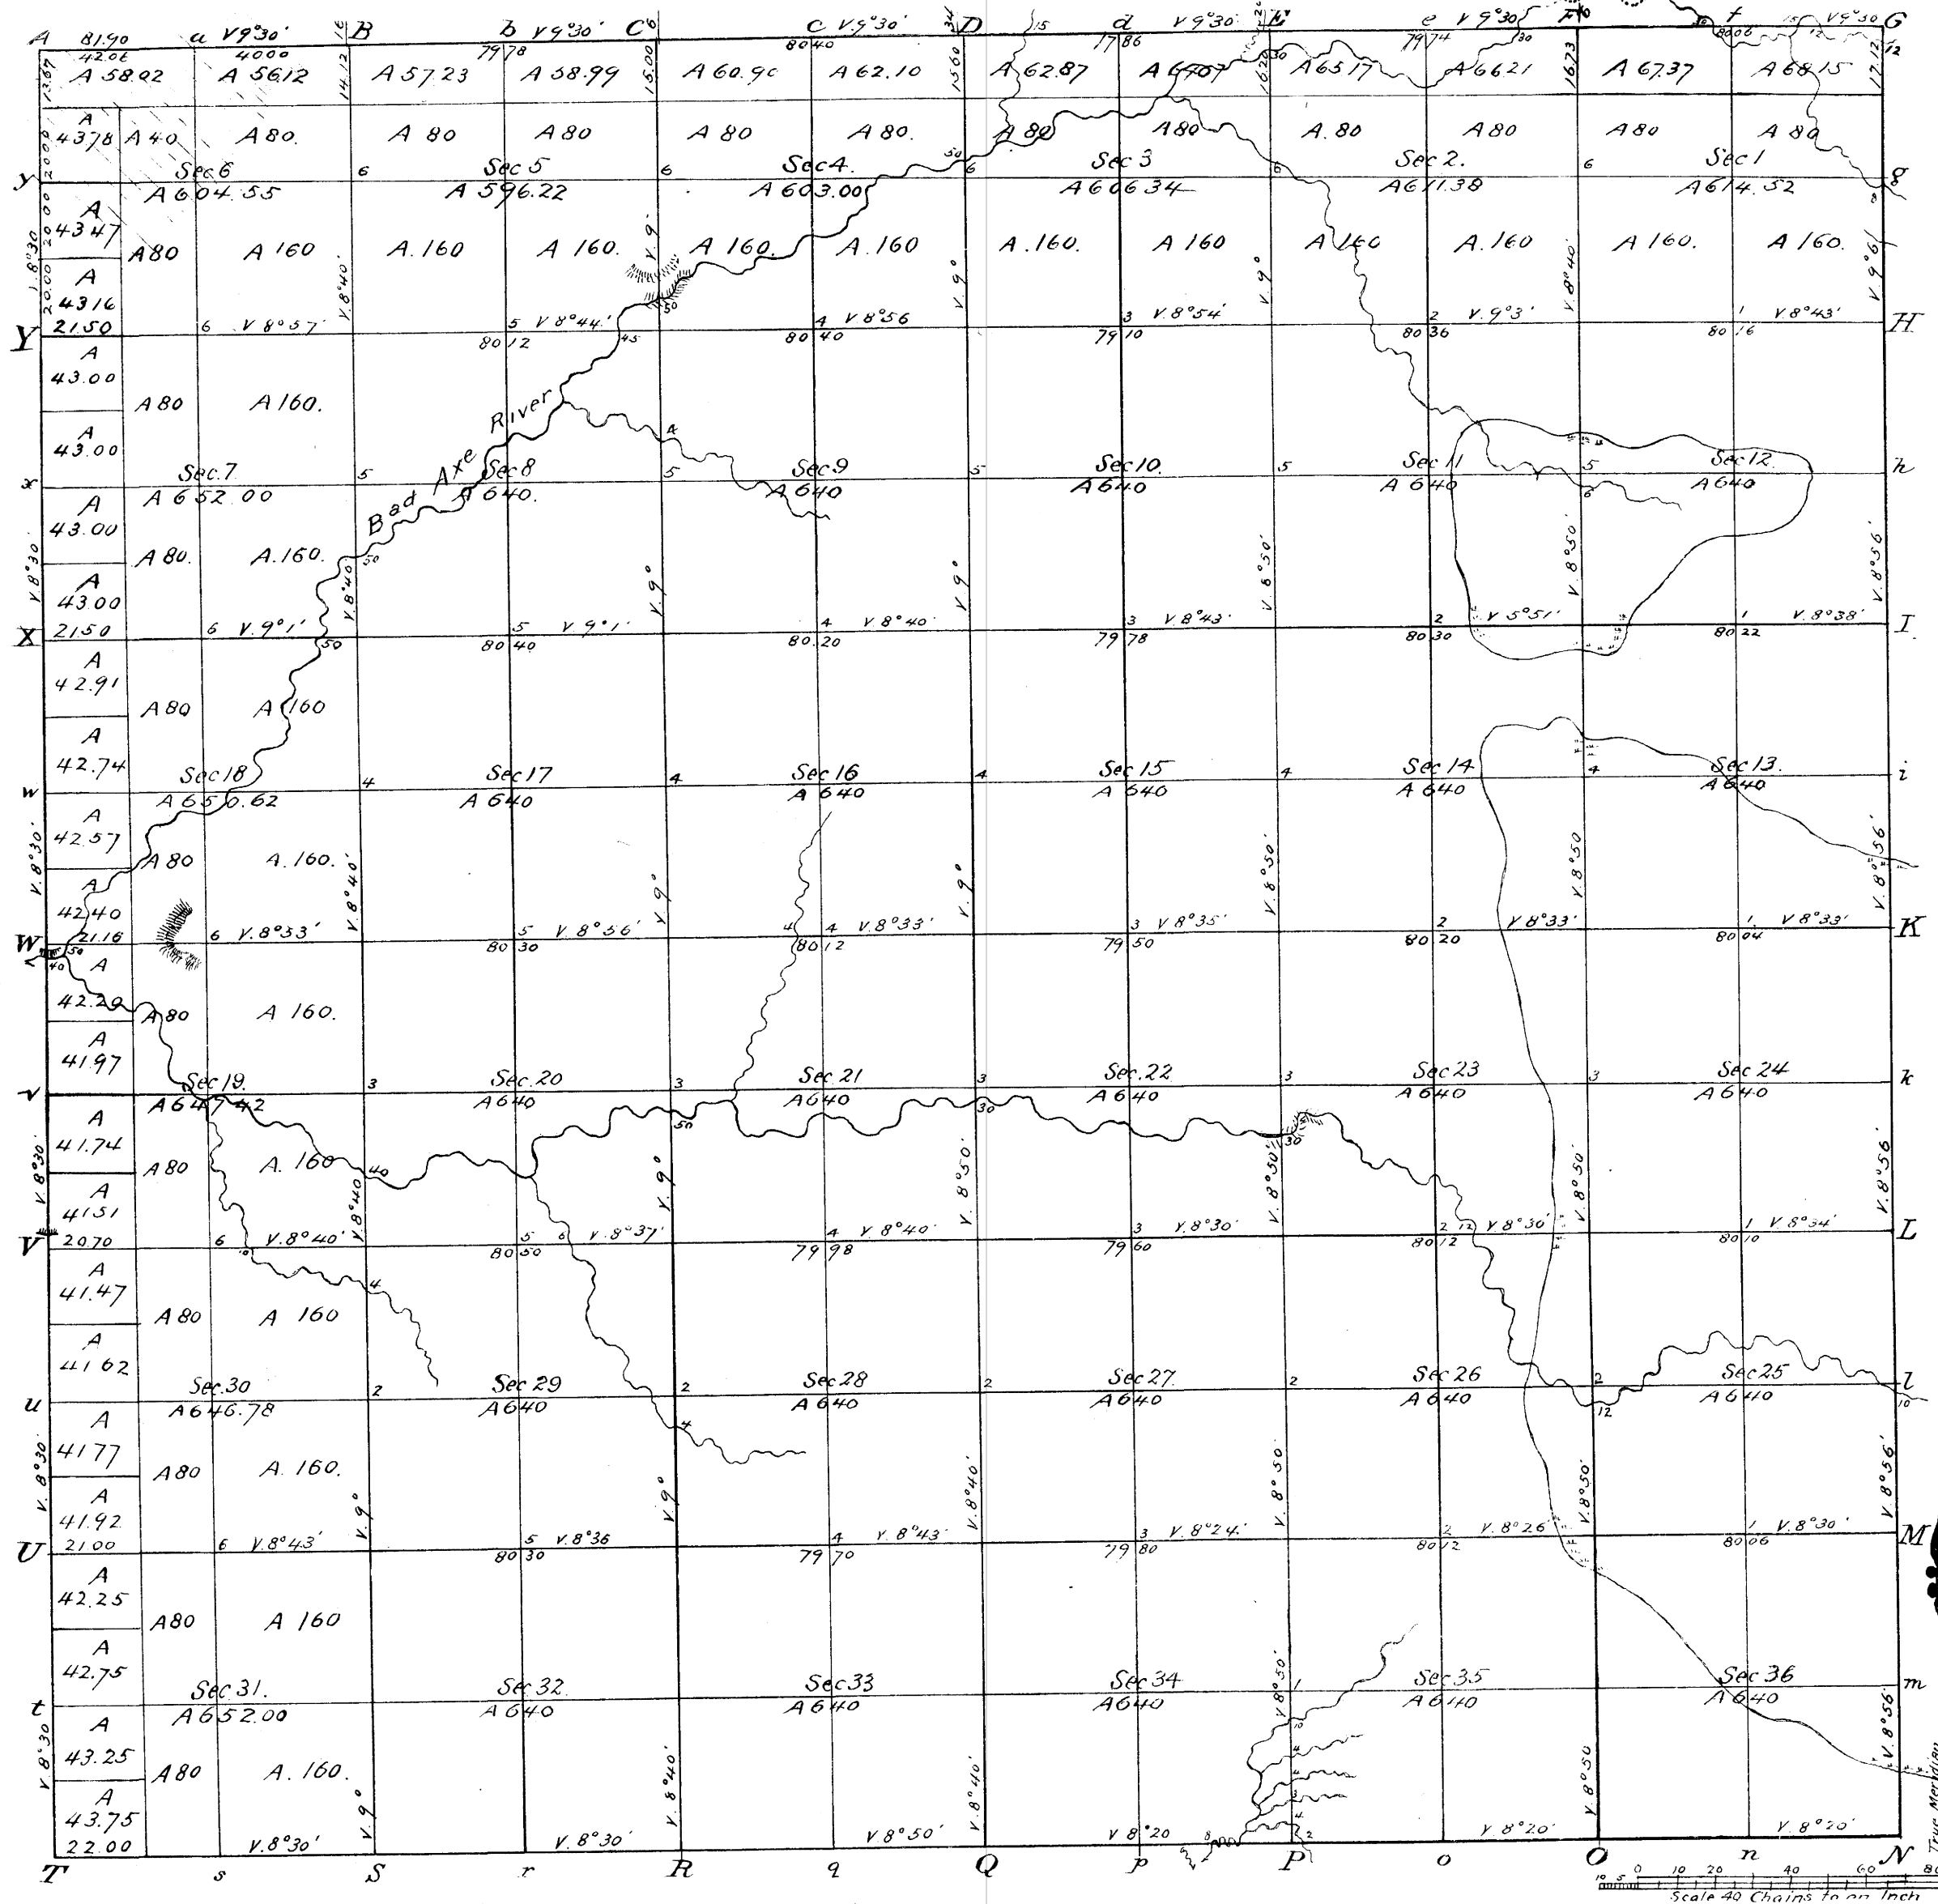

33 B

Total number of Acres 22,885.43

Surveys Designated	By Whom Surveyed	Date of Contract	Amount of Surveys	When Surveyed	When p ^d for and ch ^d in the Sur ^r Gen ^l s acc ^t
Township lines	C. C. Whitche	Nov 2 ^d 1844	M. Chs 14s 23,74.69	November 1844	
Subdivisions	Saml. Dixon	May 15, 1845	59,63.51	July, 1845	

The above Map of Township N^o 13 North of Range N^o 5 West 4th Principal Meridian Wisconsin Territory, is strictly conformable to the field notes of the survey thereof on file in this Office which have been examined and approved

Surveyor General's Office }
 Dubuque September 18, 1845 } *Gran Jones Sur. Genl.*