


Township N^o 13 North, Range N^o 6 West, 4th Mer. Dec with Sur Genl 26 May 1846.

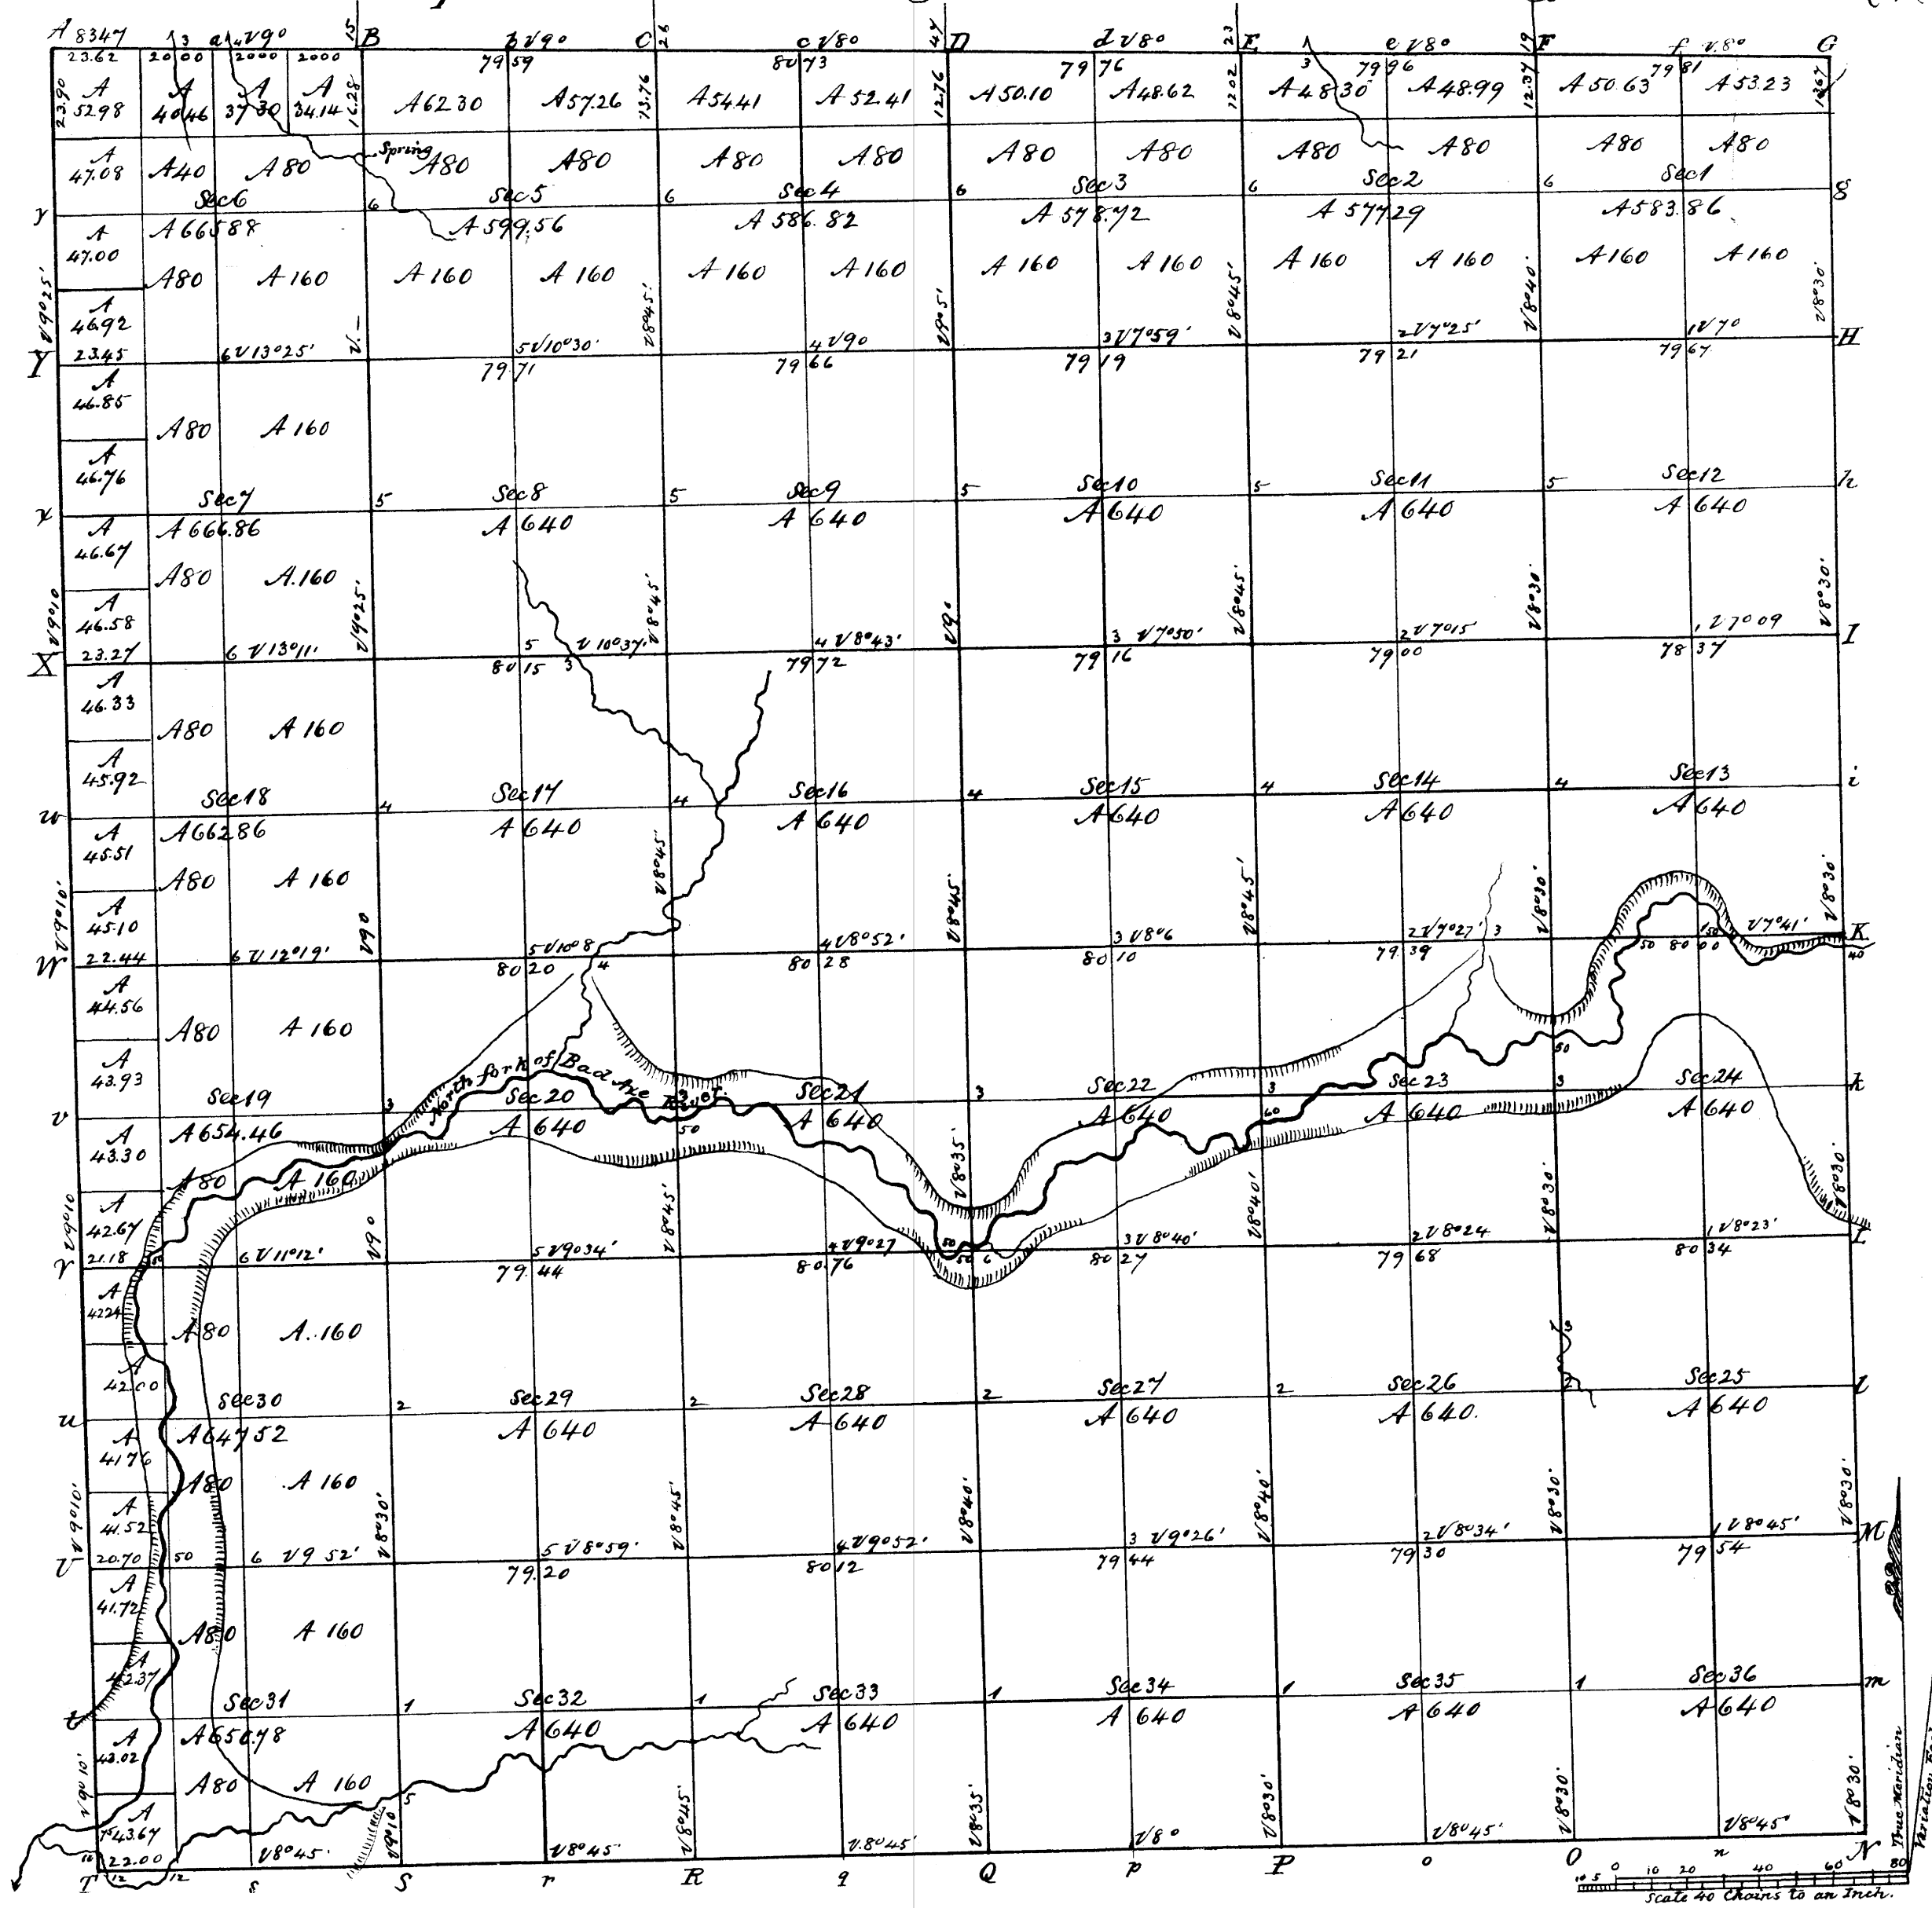

Vol. 33 B

Total number of Acres 22874.61

Surveys Designated	By Whom Surveyed	Date of Contract	Amount of Surveys	When Surveyed	Whom ² for and ch ² in the Sur ⁷ Gen ¹² acc ⁶
Township lines	J. E. Whiteside	November 2, 1844	MI ch ⁵ lks 24 03 . 04	November 1844	
Subdivisions	N. E. Whiteside	May 18, 1846 (Date of Bond)	59. 51 . 21	November 1845	

The above Map of Township N^o 13 North of Range N^o 6 West 4th Principal Meridian Wisconsin Territory, is slightly conformable to the field notes of the survey thereof on file in this Office which have been examined and approved.

Surveyor General's Office
Dubuque, May 26, 1846.

Genl Jones Sur Genl