

204116

Richland County

GOVERNMENT CORNER RECORD

NORTH 1/4 CORNER, SECTION 2, TOWNSHIP 12 NORTH, RANGE 2 EAST - WEST,
TOWN, CITY OR VILLAGE OF FOREST, RICHLAND CO.

TYPE OF MONUMENT: RICHLAND CAST IRON ELEVATION - M.S.L. DATUM _____

STATE PLANE COORDINATES: N _____

WISCONSIN SOUTH ZONE E _____

WITNESSES TO CORNER LOCATION

RECORDED

AT 9:00 O'CLOCK A M


OCT 1 1991

SEAN WALSH

BILLY POLLOCK

BY Sy Miller
SY MILLER, REGISTER OF DEEDS
RICHLAND COUNTY, WISCONSIN

SECTION 2, T 12 N, R 2 EW
TOWN OF FOREST

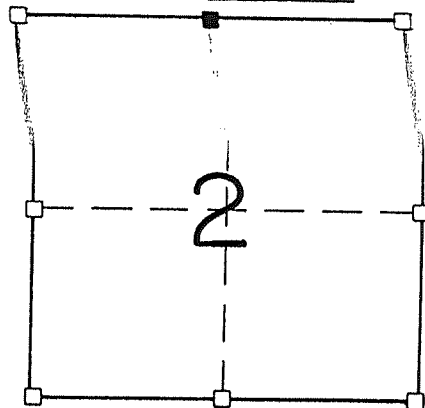

■ - CORNER LOCATION

NORTH

TIE SKETCH
(SHOW ALL HELPFUL FEATURES)

Ø 3/4" x 24" IRON ROD

T 2" CHANNEL POST W/GOV'T SIGN

← X X FENCELINE

I.R.S.
VERNON PASTURE

COUNTY

77.58'

104.08'

79.48'

2.44'

GOV'T SIGN

RICHLAND PASTURE
FIELD

COUNTY

SURVEYOR'S CERTIFICATE

STATE OF WISCONSIN)
RICHLAND COUNTY)SS

SEAL s- 2016

I, Sean M. Walsh, DO HEREBY CERTIFY THAT I have established
this corner according to the information shown hereon
and that this information is correct and true to the
best of my knowledge, information and belief. I
established this corner by single proportionate
measure as there is no other acceptable evidence.



Sean M. Walsh
REGISTERED LAND SURVEYOR

DATED THIS 30TH DAY OF September, 19 91

CORNER CODE

4

BB