

202055

Richland County

GOVERNMENT CORNER RECORD

NORTHWEST CORNER, SECTION 3, TOWNSHIP 12 NORTH, RANGE 2 ~~EAST~~ - WEST,
TOWN, ~~CITY OR VILLAGE~~ OF FOREST, RICHLAND CO.

TYPE OF MONUMENT: RICHLAND CAST IRON ELEVATION-M.S.L. DATUM _____

STATE PLANE COORDINATES: N _____

WISCONSIN SOUTH ZONE E _____

WITNESSES TO CORNER LOCATION

SEAN M. WALSH

PATRICK J. DEDERICH

RECORDED

9:00 O'CLOCK A M.

DEC 31 1990

OL. 1 OF Corners PAGE 7
BY SY MILLER, REGISTER OF DEEDS
RICHLAND COUNTY, WISCONSIN
Sy Miller

TIE SKETCH
(SHOW ALL HELPFUL FEATURES)

3/4" X 24" IRON ROD SET AT
E/S SMALL ROCK OUTCROPPING

TOWN OF STARK, VERNON COUNTY

2" CHANNEL POST
W/ GOV'T SIGN

50.01'

STEEP WOODED HILLSIDE

SOUTHWEST CORNER SECTION
34, T13N, R2W
3/4" X 48" IRON ROD SET

3.25'

87.78'

STEEP WOODED HILLSIDE

14.37'

30.01'


WOODED HILLSIDE

3/4" X 24" IRON ROD SET

TOWN OF FOREST, RICHLAND COUNTY

RAVINE

SECTION 3, T 12 N, R 2 ~~EW~~
TOWN OF FOREST

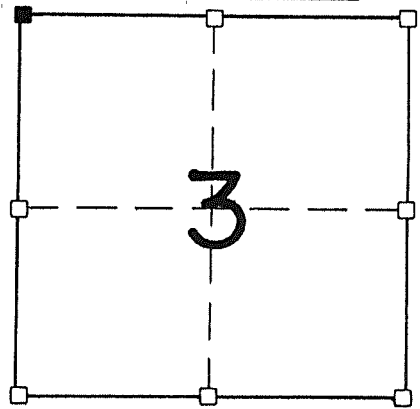

■ - CORNER LOCATION


NORTH

SURVEYOR'S CERTIFICATE

STATE OF WISCONSIN)
RICHLAND COUNTY) SS

SEAL S-1454

I, Matthew J. Janiak, DO HEREBY CERTIFY THAT the above corner
has been established under my direction and supervision in
accordance with the information contained hereon and that
this information is correct and true to the best of my
knowledge, information and belief. After finding no evidence
record or physical this corner was established at the

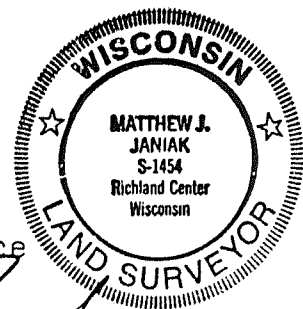

DATED THIS 20th DAY OF DECEMBER, 19 90

REGISTERED LAND SURVEYOR

CORNER CODE

BB

CORNER MAINTANENCE INFORMATION

CORNER APPROVED X , DATE 12-26-90

[Handwritten Signature]
 RICHLAND COUNTY SURVEYOR, S-1457

ADDITIONAL INFORMATION IF NECESSARY

location at the correction distance specified by the original government survey on line between the Southwest Corner of section 34 T13N. R2W, and the next occupied corner to the West.