

203098

Richland County

GOVERNMENT CORNER RECORD

NORTHEAST CORNER, SECTION 5, TOWNSHIP 12 NORTH, RANGE 2 ~~EAST~~ - WEST,
TOWN, ~~CITY OR VILLAGE~~ OF FOREST _____, RICHLAND CO.

TYPE OF MONUMENT: RICHLAND CAST IRON ELEVATION - M.S.L. DATUM _____

STATE PLANE COORDINATES: N _____

WISCONSIN SOUTH ZONE E _____

WITNESSES TO CORNER LOCATION

SEAN M. WALSH

PATRICK J. DEDERICH


RECORDED

AT 8:30 O'CLOCK A M

JUN 13 1991

VOL. 1 OF Covers PAGE 9
BY Sy Miller
SY MILLER, REGISTER OF DEEDS
RICHLAND COUNTY, WISCONSIN


TIE SKETCH
(SHOW ALL HELPFUL FEATURES)

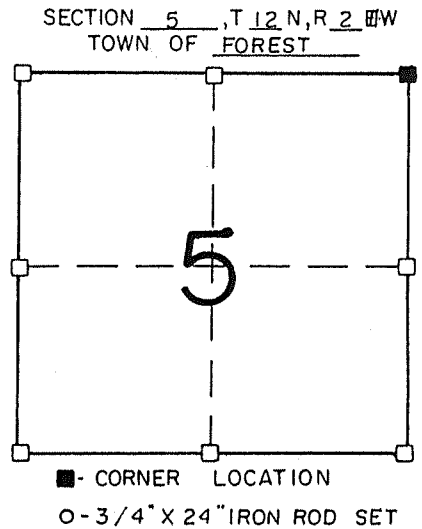

WOODED

VERNON COUNTY

WOODED

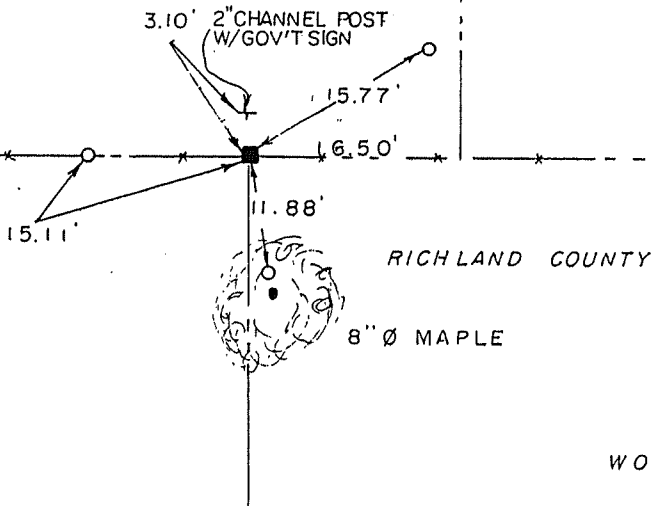

WOODED

WOODED

SURVEYOR'S CERTIFICATE
STATE OF WISCONSIN)
RICHLAND COUNTY) SS

I, Sean M. Walsh, DO HEREBY CERTIFY THAT I established the above
corner at the location of a cedar stake that I found near
the remains of an old fence corner, this location measures
very close to the last recorded location as set by M.O. Carter
in 1960. I decided that this this was the best possible
location for this corner as no other evidence exists.



Sean M. Walsh
REGISTERED LAND SURVEYOR

DATED THIS 3RD DAY OF JUNE, 19 91

CORNER CODE