

203097

# Richland County

## GOVERNMENT CORNER RECORD

NORTHWEST CORNER, SECTION 5, TOWNSHIP 12 NORTH, RANGE 2 EAST - WEST,  
TOWN, CITY OR VILLAGE OF FOREST, RICHLAND CO.

TYPE OF MONUMENT: RICHLAND CAST IRON ELEVATION - M.S.L. DATUM \_\_\_\_\_

STATE PLANE COORDINATES: N \_\_\_\_\_

WISCONSIN SOUTH ZONE E \_\_\_\_\_

WITNESSES TO CORNER LOCATION

SEAN M. WALSH

PATRICK J. DEDERICH


**RECORDED**

AT 8:30 O'CLOCK A M

JUN 13 1991

VOL. 1 OF Corners PAGE 4  
BY Sy Miller  
SY MILLER, REGISTER OF DEEDS  
RICHLAND COUNTY, WISCONSIN

TIE SKETCH  
(SHOW ALL HELPFUL FEATURES)

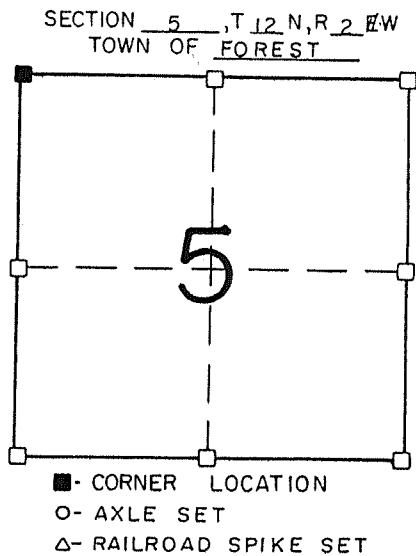

NORTH

VERNON COUNTY

PASTURE

2" CHANNEL POST  
W/ GOV'T SIGN

14.28'

41.82'

54.25'

LIEURANCE

ROAD

YARD

30.81'

YARD

RICHLAND COUNTY

SURVEYOR'S CERTIFICATE

STATE OF WISCONSIN )  
RICHLAND COUNTY ) SS

SEAL S- 2016:

I, Sean M. Walsh, DO HEREBY CERTIFY THAT I established the above corner at the occupied location after excavating the road and not finding the old stone of record. this location fits very well with old information between other corners along the north line of the township, and that this information is correct to the best of my information, knowledge and belief.



DATED THIS 3<sup>RD</sup> DAY OF JUNE, 1991

Sean Walsh  
REGISTERED LAND SURVEYOR

CORNER CODE

BB