


| | | |
|--|---|-----------------|
| PROJECT # 380102 | SCALE: 1" = 1000 FEET | FILE # 38-27-18 |
| FIELD BOOK # 1237 | DRAWN BY KZZ | SHEET # 1 OF 1 |
| PAGES # 14-20 | CHECKED BY KZZ | SIDE # 1 OF 1 |
| SURVEYOR: MID-STATE ASSOCIATES, INC. 1230 SOUTH BOULEVARD BARABOO, WI 53913 (808 356-2771) | MSA BARABOO, WISCONSIN 53913 © 1993 MID-STATE ASSOCIATES | CLIENT: |

SECTION SUMMARY & INDEX

28
SECTION

13N
TOWN

ZW
RANGE

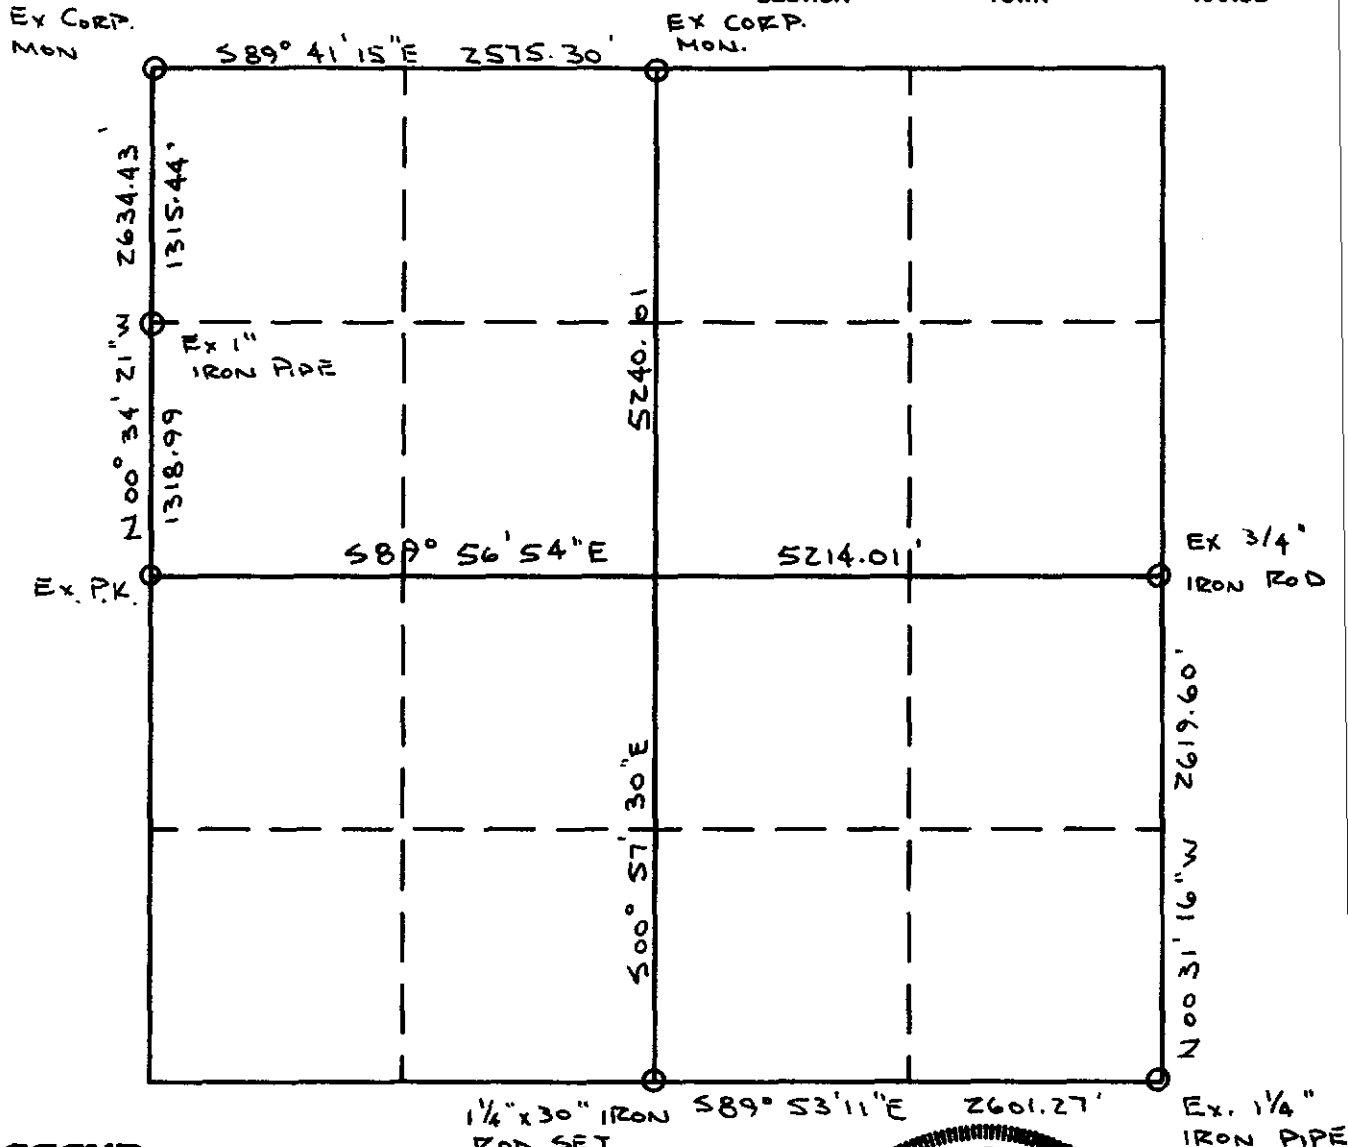

LEGEND

- HARRISON CAST IRON MONUMENT
- STONE OR CONCRETE MONUMENT
- OTHER (AS NOTED)



Kerry R. Ziegler 12-18-02