


COUNTRY U. S. A.		TYPE OF MARK 2" IRON PIPE WITH BRASS CAP		STATION 1/4 CORNER 9/16		T. 13 N. R. 2 W.	
LOCALITY LA FARGE, WIS.		STAMPING ON MARK 9/16		AGENCY (CAST IN MARKS) CORPS OF ENGRS.		ELEVATION (FT) (M)	
LATITUDE		LONGITUDE		DATUM		DATUM	
(NORTHING)(EASTING) (FT) (M)	(EASTING)(NORTHING) (FT) (M)	GRID AND ZONE WIS. (SOUTH)		ESTABLISHED BY (AGENCY) CHICAGO DISTRICT			
(NORTHING)(EASTING) (FT) (M)	(EASTING)(NORTHING) (FT) (M)	GRID AND ZONE		DATE 1965		ORDER	

TO OBTAIN GRID AZIMUTH, ADD TO THE GEODETIC AZIMUTH  
 TO OBTAIN GRID AZ. (ADD)(SUB.) TO THE GEODETIC AZIMUTH

OBJECT	AZIMUTH OR DIRECTION		BACK AZIMUTH	GEOD. DISTANCE		GRID DISTANCE	
	(GEODETIC)	(GRID)		(METERS)	(FEET)	(METERS)	(FEET)
POINT NEAR 9/16							
REF. No. 1		N. 17°-30'-24" W.					96.97
REF. No. 2		NORTH					19.80
REF. No. 3		S. 45° W.					21.25
		N. 55° W.					12.39

REFERENCE DISTANCES ARE HORIZONTAL & TO NAILS IN TREES, REFERENCE TREES TO 1/4 CORNER ARE BLAZED & SCRIBED E. CORNER IS APPROX. 165' SOUTH OF GRAVEL ROAD.

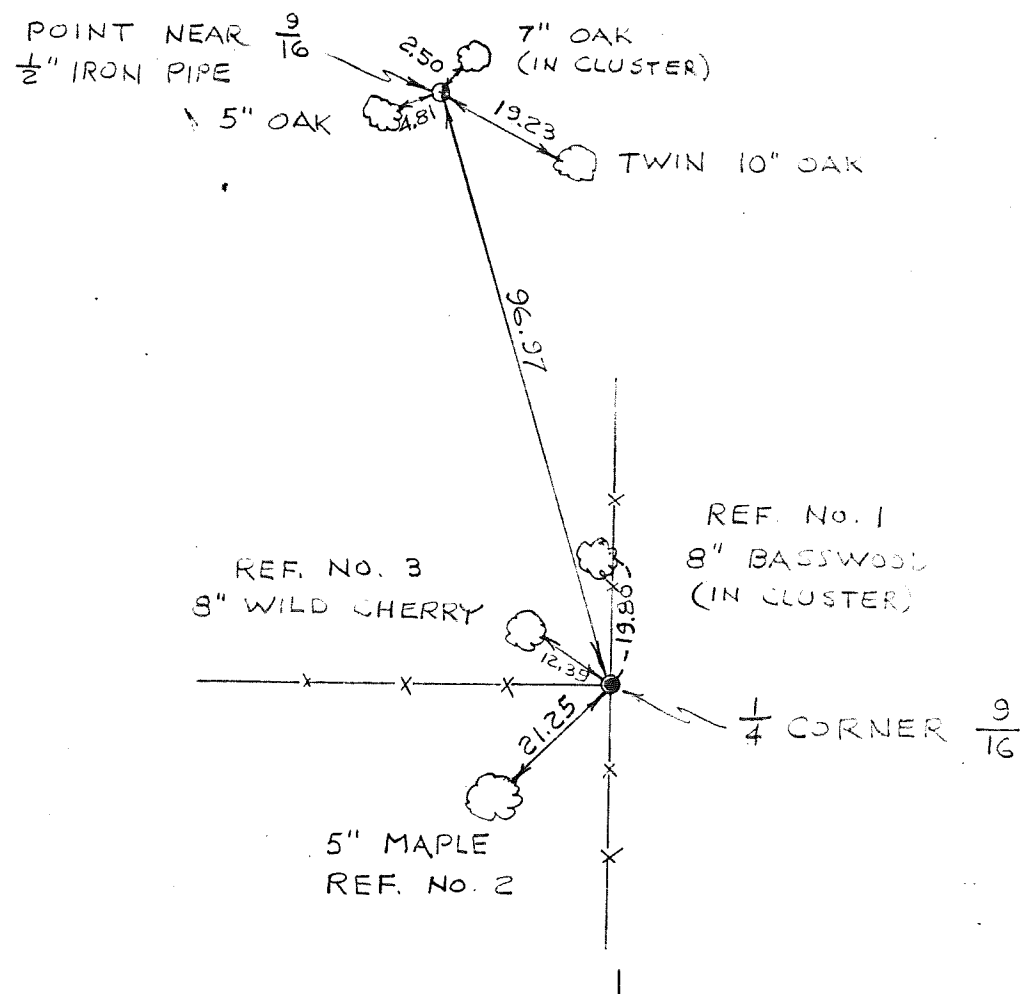

SKETCH

US Army Corps of Engineers



Saint Paul District

PROJECT TITLE:

LaFarge, WI

COMPUTED BY:

*[Signature]*

DATE:

15 Feb 02

SHEET:

1 of 1


SUBJECT TITLE:

Land Lines T13N, R2W  $\frac{17}{20}$ / $\frac{16}{21}$

CHECKED BY:

DATE:

CONTRACT NO.:

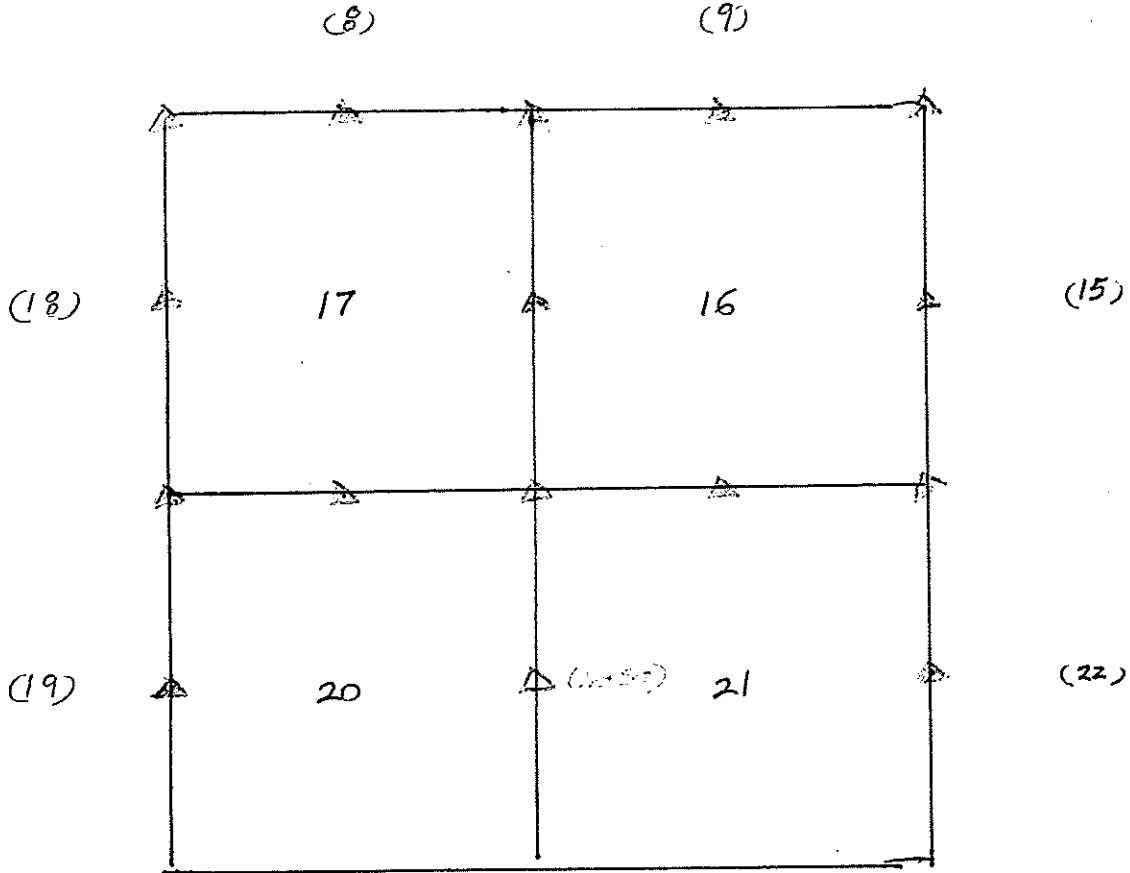

*△ - See PD Pt 122A-213 for Contour Elevation*

KICKAPOO RIVER  
LA FARGE, WIS.

(44) OF (83)

PROPERTY SURVEY


6 NOV. 1965

⌘ B.S. E.S. 4 RT.

BEARINGS TO WITNESS TREES  
(MAGNETIC BEARINGS)

REF	BEARING	DIST.
No. 1	NORTH	19.80
No. 2	S. 45° W.	21.25
No. 3	N. 55° W.	12.33

REFERENCE TREES ARE BLAZED &  
SCRIBED  $\bar{6}$ . DISTANCES ARE  
HORIZONTAL & TO NAILS IN THE  
TREES. NAILS ARE APPROX. 0.5  
ABOVE GROUND & POINT AT CORNER

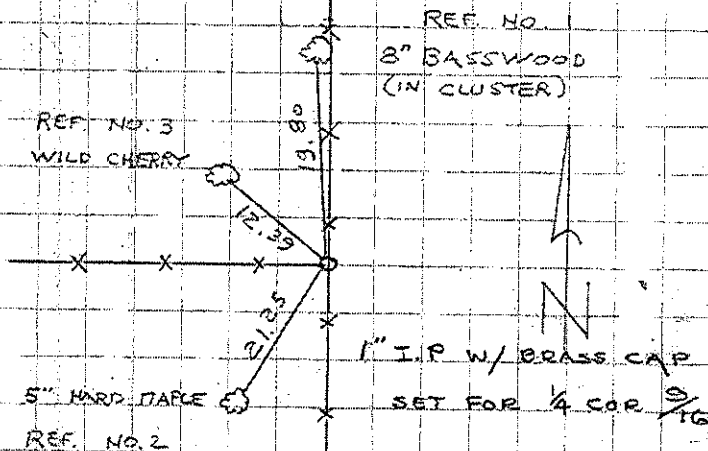

$\frac{9}{16}$

GENERAL COMMENTS

1. Accepted fence corner -  
of this corner new, although 126' E is in a short gully (. Note:  
Gov't Surveyor in this Township was picking up natural marks  
on his random lines - random would have been some 35' North  
of corner.)
2. No other ref. found.
- 3.