



Section Summary and Index

Section 7 - 14 - 1E
Town Range

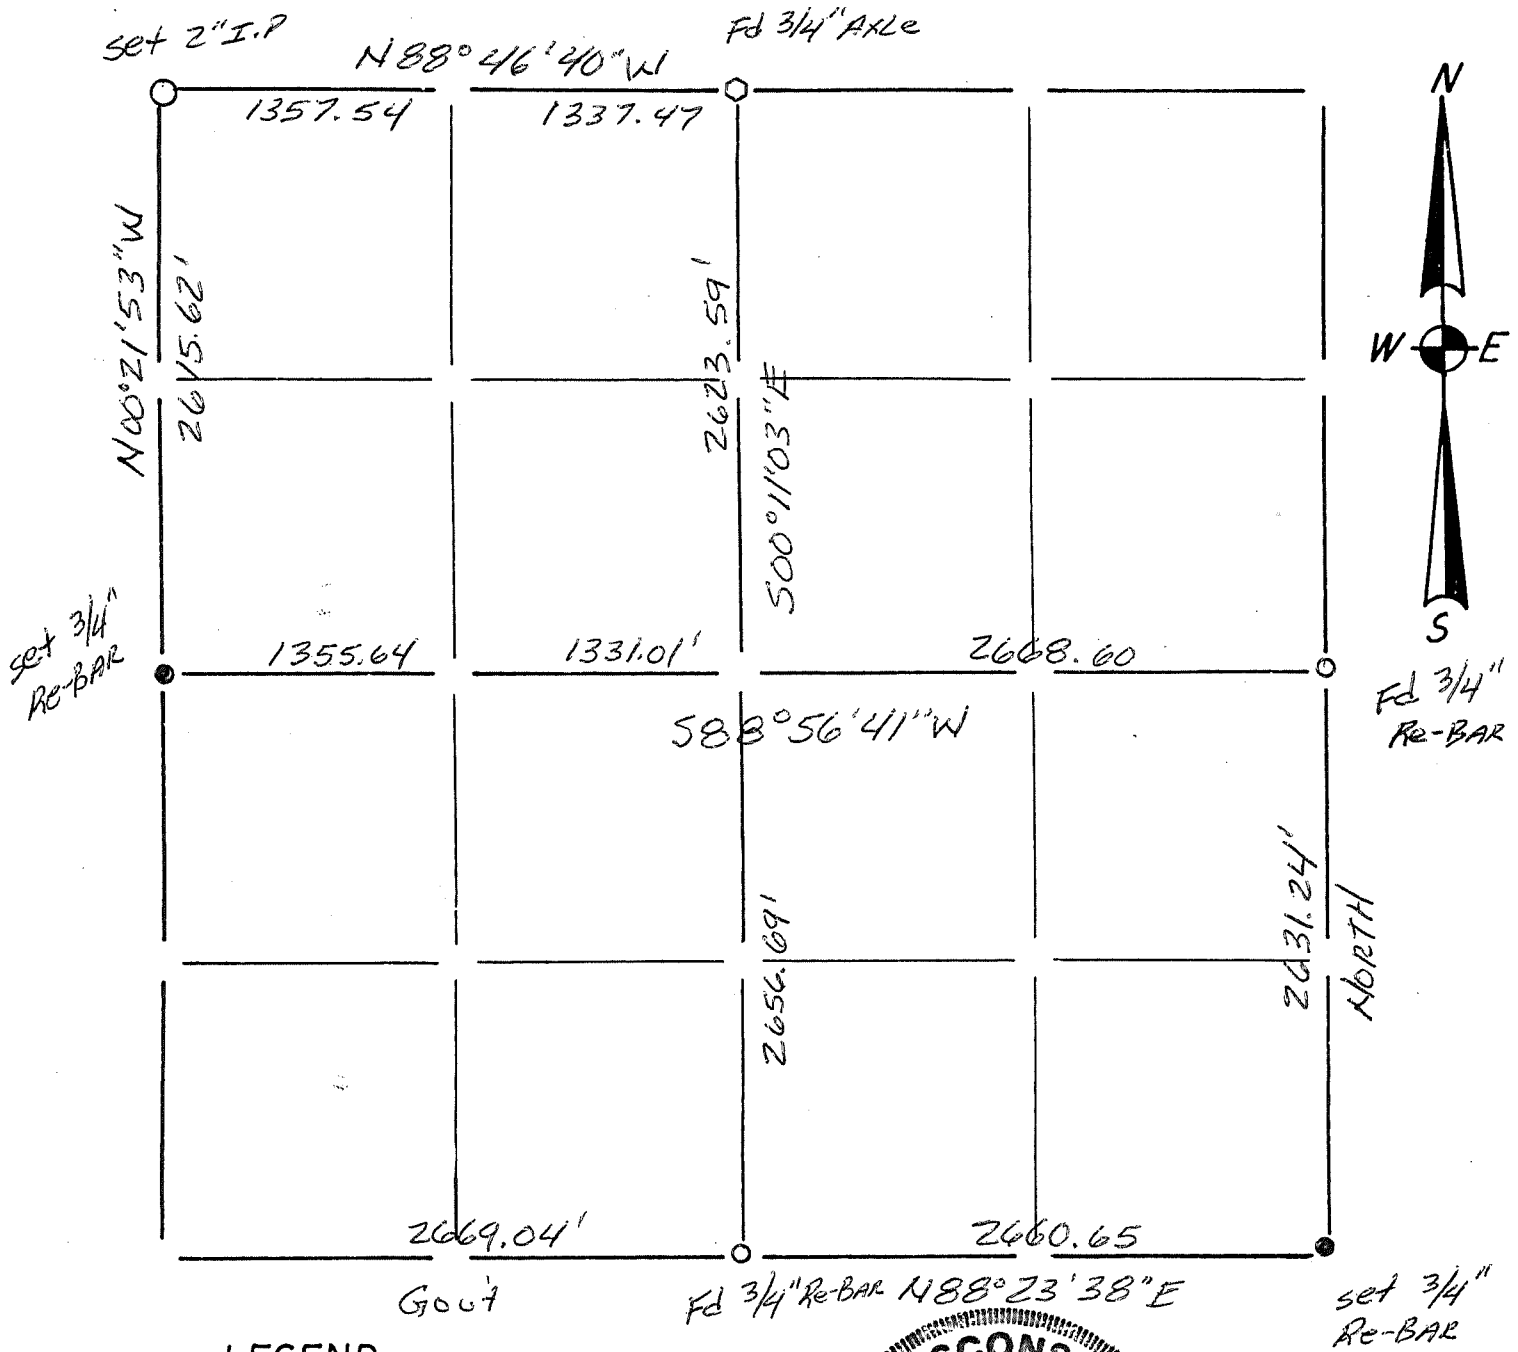

LEGEND

- ⊕ - Harrison cast iron monument.
- - Stone or concrete monument.
- - Other _____

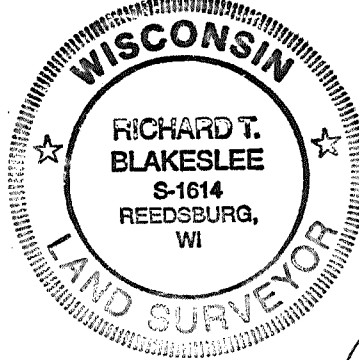

Richard T. Blakeslee
5/17/99

Summary of Pg. 30-32