


# Data Sheet

Section 9, T14N, R1E

Town of Hillsboro, Vernon County, Wisconsin

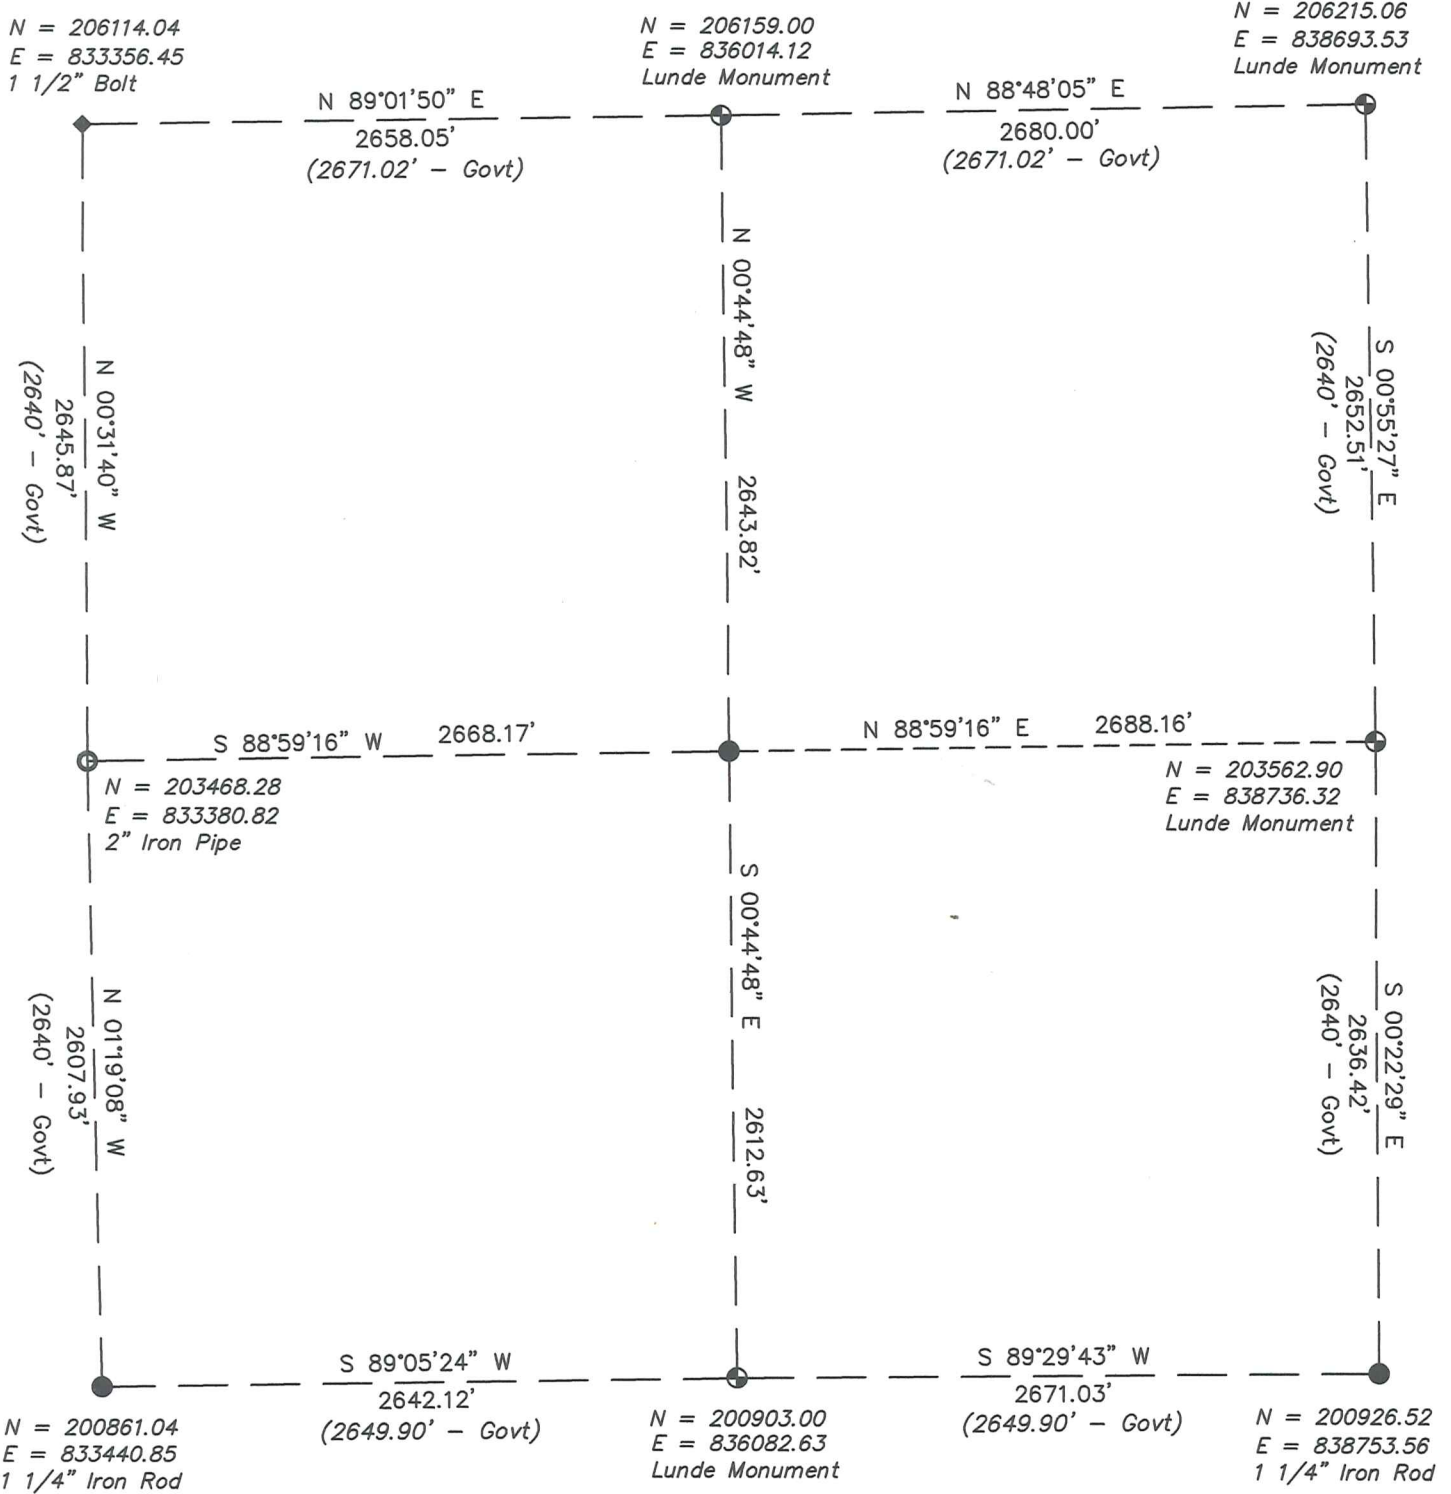

WISCONSIN  
 LAURENCE E. JOHNS III  
 S-2804  
 WILTON, WISCONSIN  
 LAND SURVEYOR  
 21 MAY 07

SCANNED

BB