
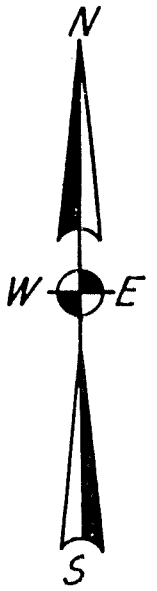



Section Summary and Index

Section 14 - 14 - 1E
 14 14 1E

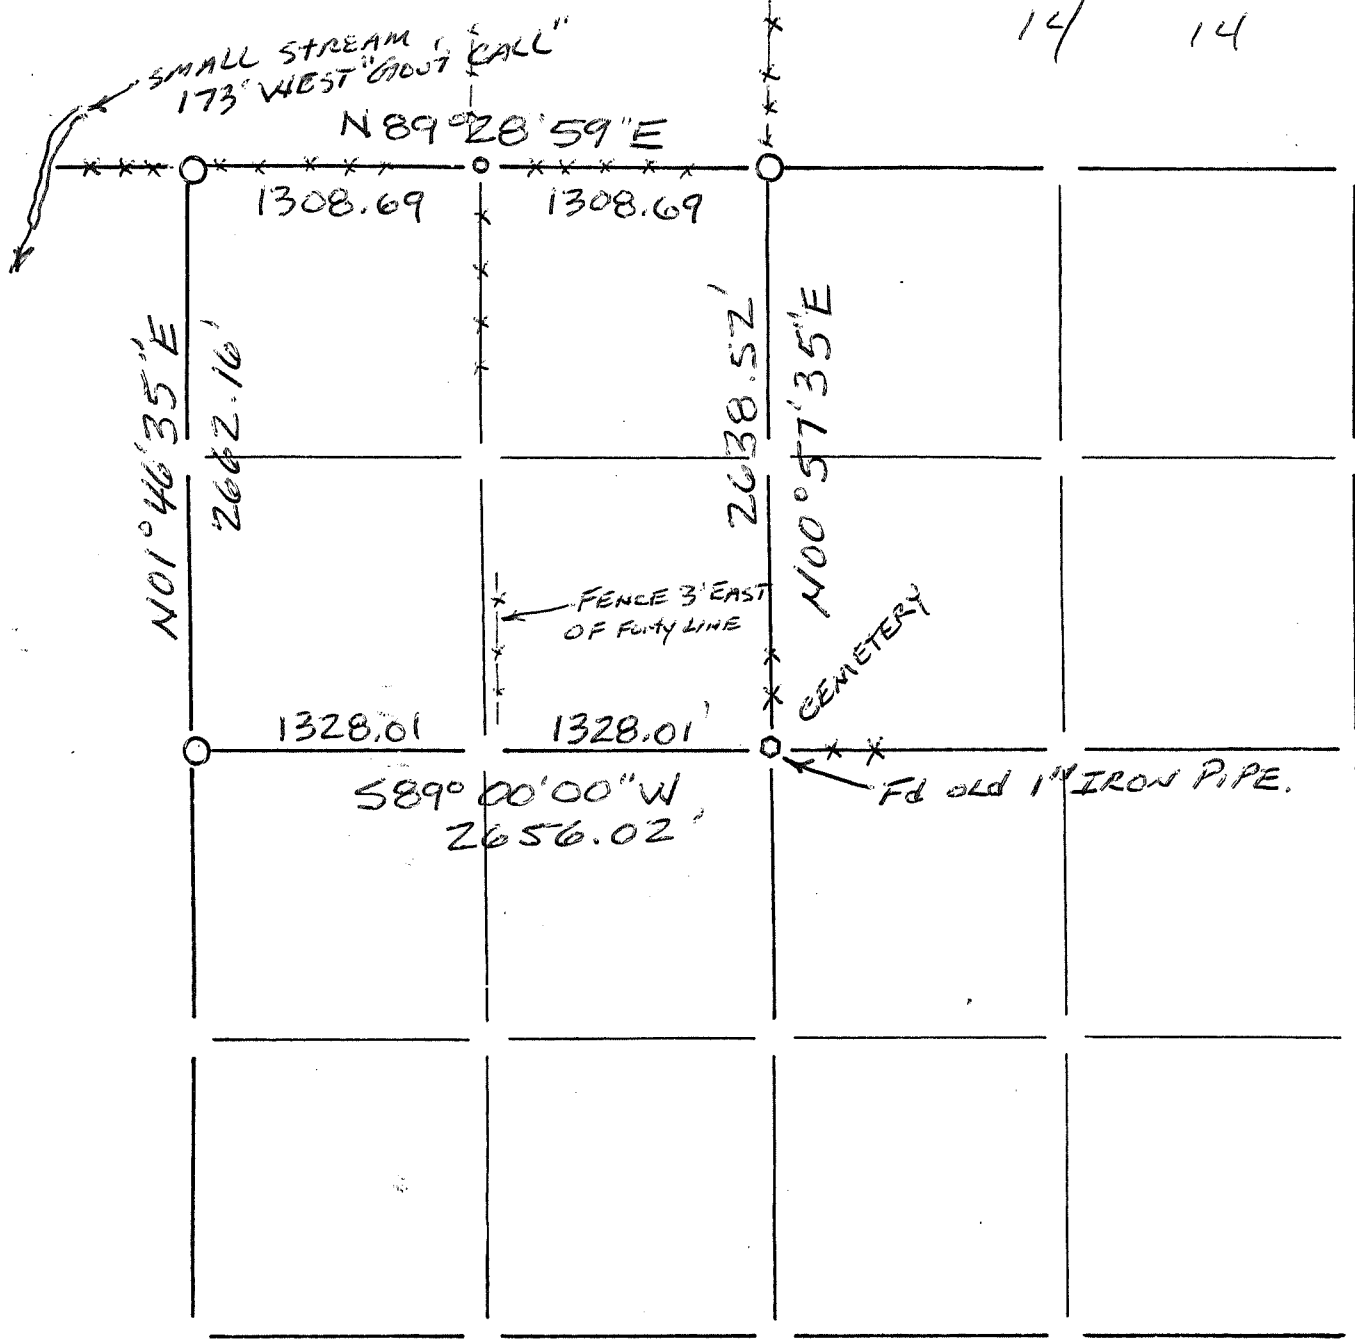

LEGEND

- ⊕ - Harrison cast iron monument.
- - Stone or concrete monument.
- - Other 1/4" RE-BAR SET
- set 3/4" RE-BAR
- 1" IRON PIPE Fd.

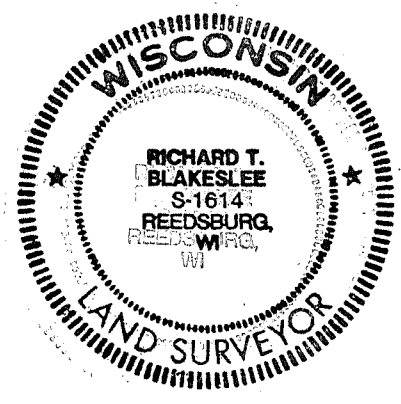

Richard T. Blakeslee
 3-21-03

70