


Section Summary and Index

27 - 14N - 2E
 Section Town Range
 TN HILLSBORO VERNON CO

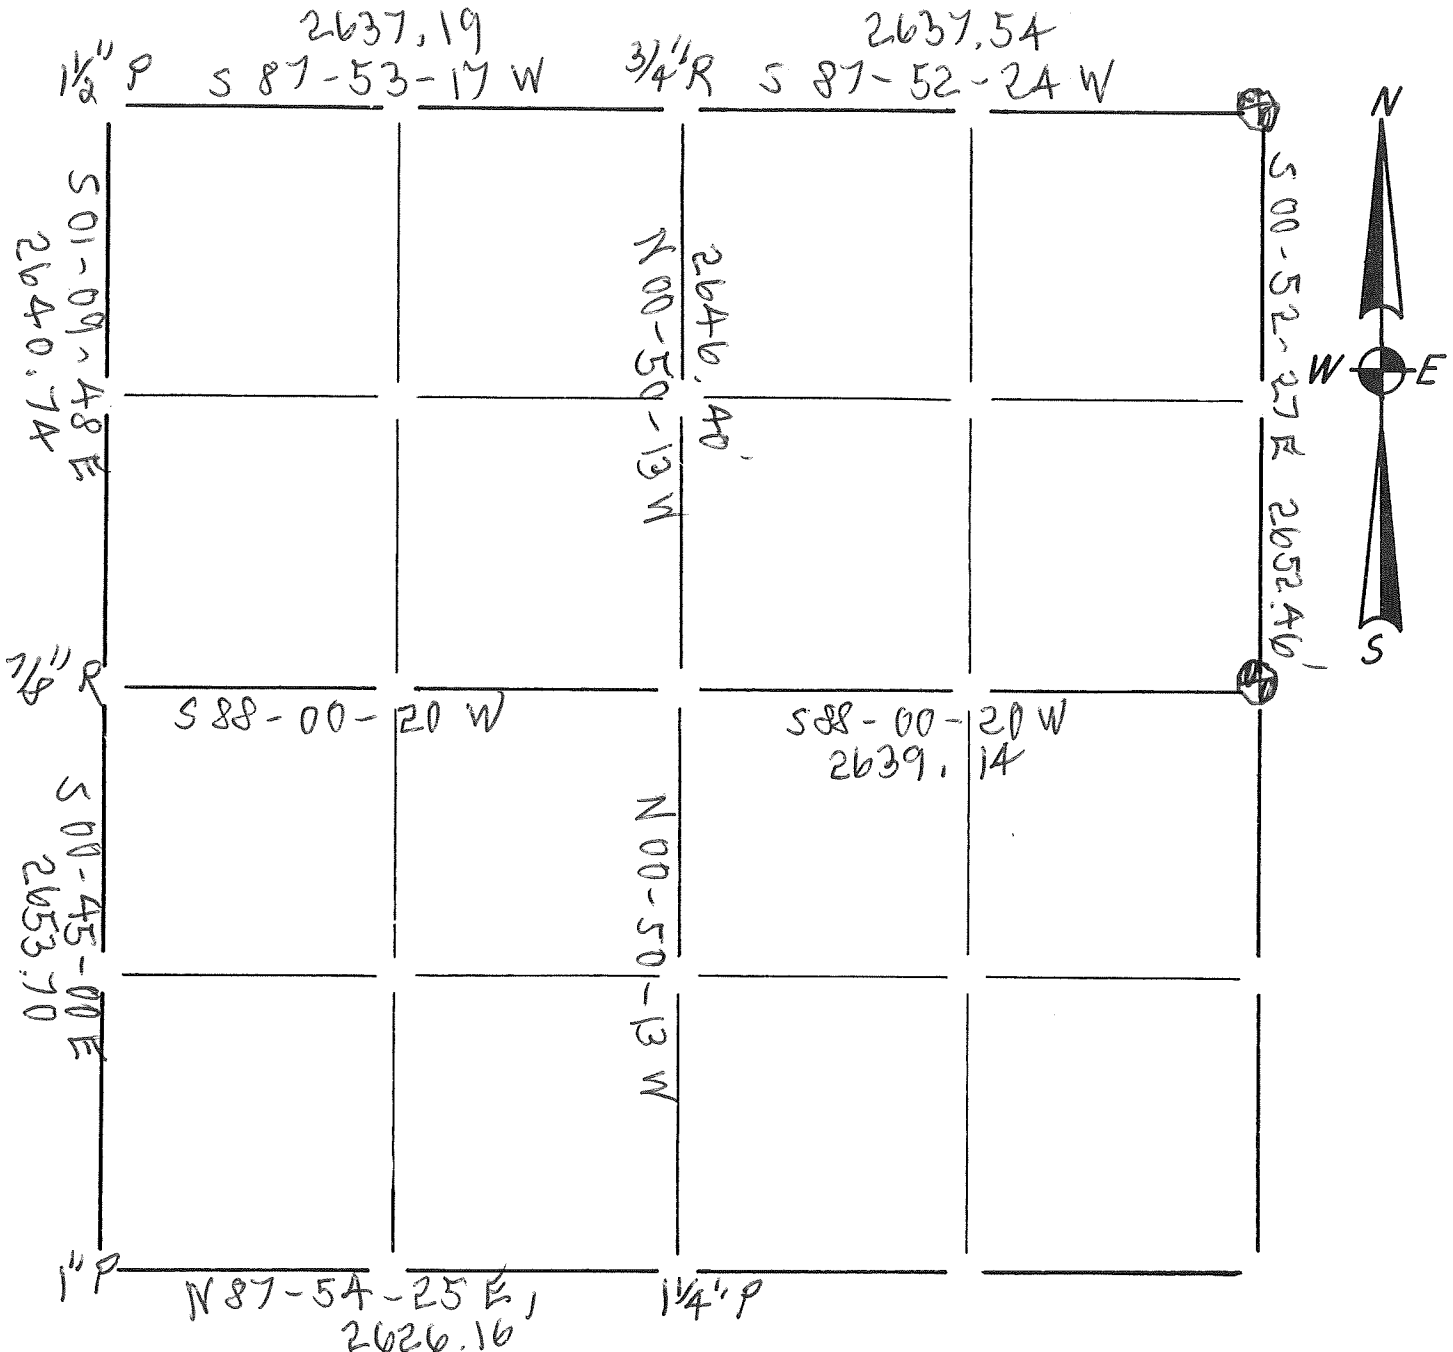

LEGEND

- - Harrison cast iron monument. 4" ALUM VERNON CO, MON.
- - Stone or concrete monument.
- - Other _____

Paul A. [Signature]
 5/15/15