
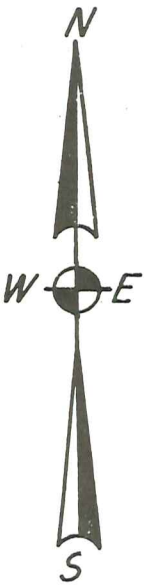


Section Summary and Index

RECEIVED  
 AUG 14 2006  
 S. Johnson  
 BY: 3/4" RE-BAR FOR COR.

31 - 14N - 1E  
 Section Town Range

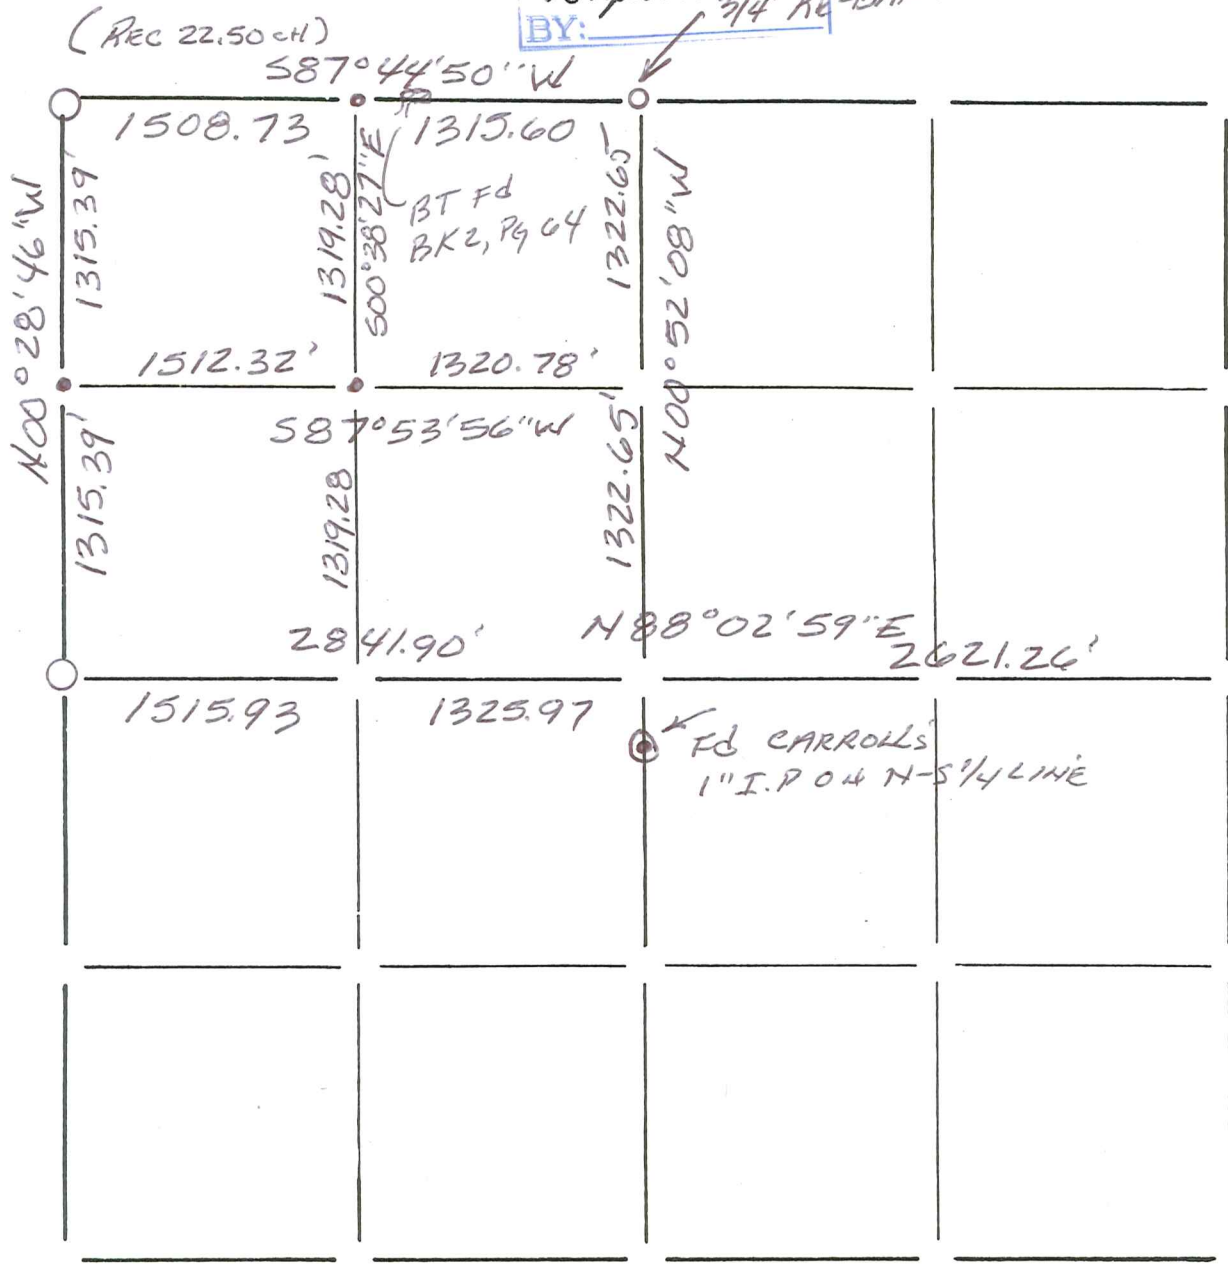

LEGEND

- ⊕ - Harrison cast iron monument.
- - Stone or concrete monument.
- - Other VERNON Co. Mon.
- - 3/4" x 18" RE-BAR SET



Richard T. Blakeslee  
 8-10-06