


Section Summary and Index


32 - 14N R1E
 Section Town Range

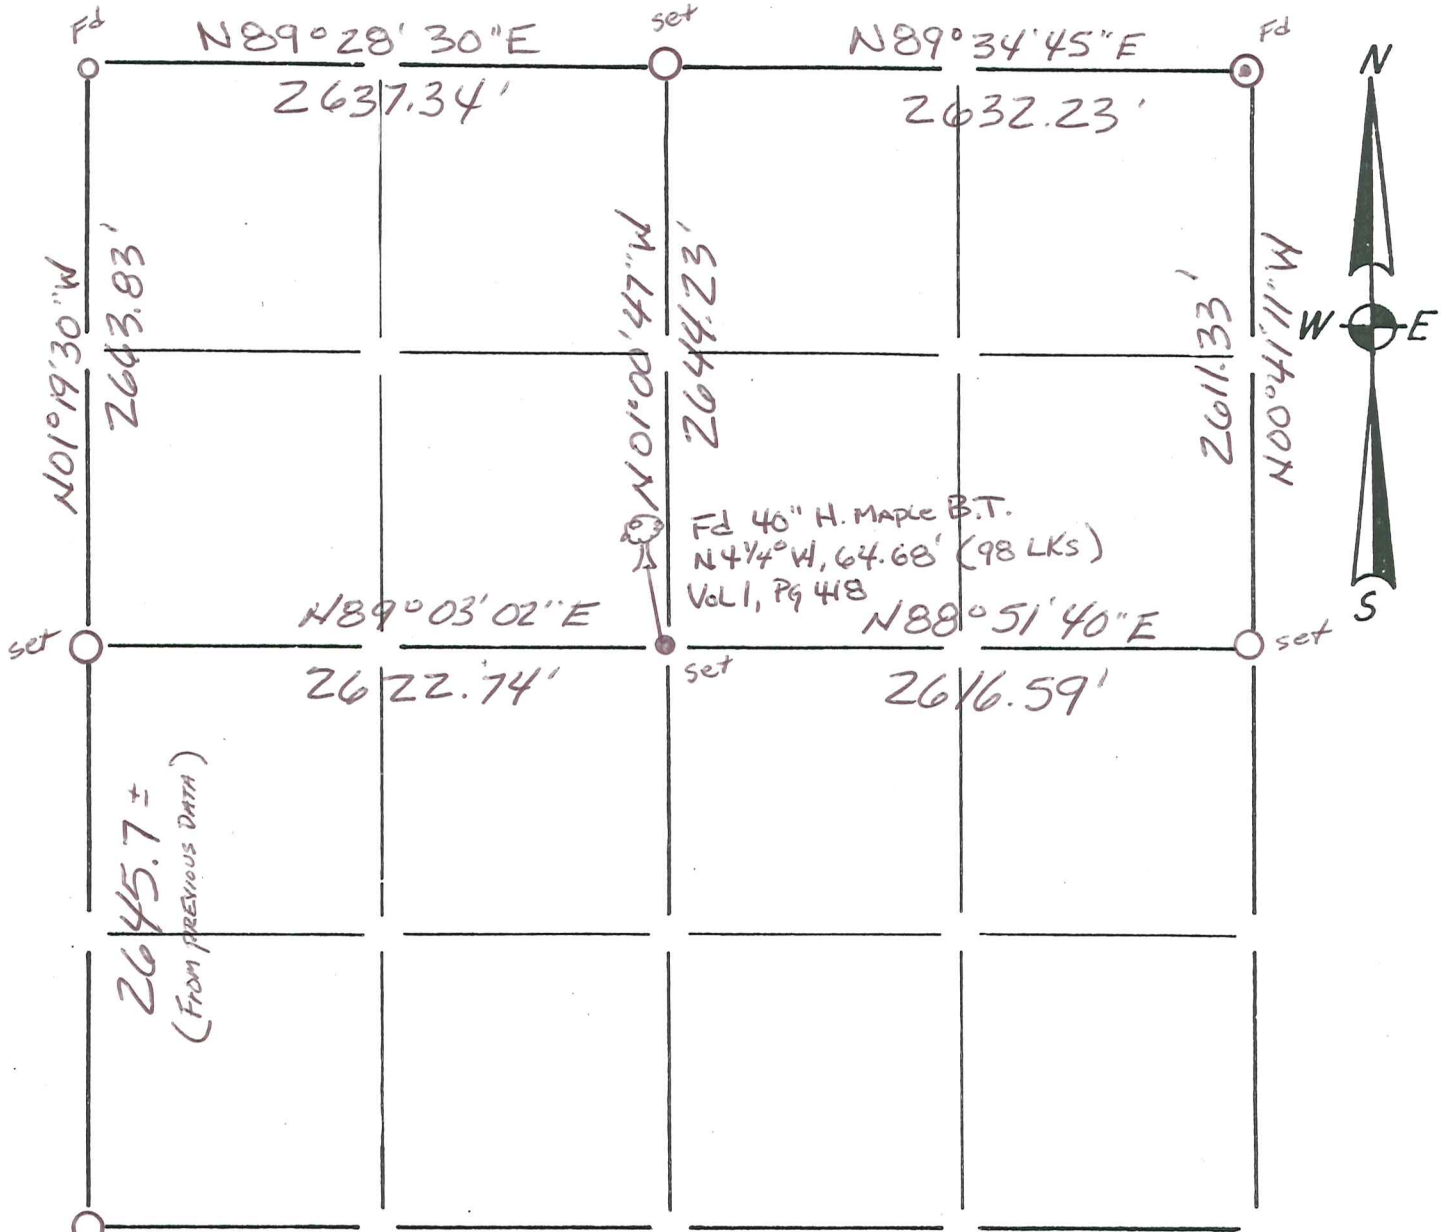

Fd (From original B.T.)

LEGEND

- ⊕ - Harrison cast iron monument.
- - Stone or concrete monument.
- - Other Vernon Co. Monument set
- - 1" I.P. Found.
- ⊙ - 1 1/4" I.P. Found
- - 3/4" x 18" RE-BAR Set

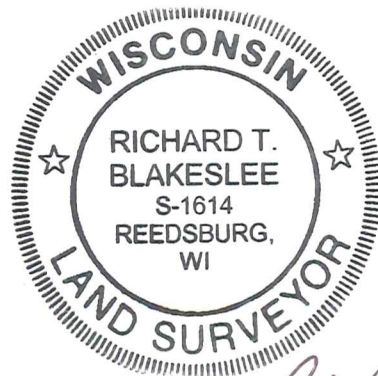

Richard T. Blakeslee
 4-4-07

SCANNED