

JUNEAU COUNTY SURVEY MONUMENT RECORD

CORNER NO. 81
SECTION 19
TOWN 14N.
RANGE 2E.


TYPE OF MONUMENT: LUNDE MONUMENT

JUNEAU COUNTY COORDINATES
NORTHING: 110,702.72
EASTING: 400,304.22

■ = CORNER MONUMENT RESTORED

BASIS FOR MONUMENT LOCATION
(USE REVERSE SIDE IF NECESSARY)

SHOW INFO SUCH AS: HISTORY OF CORNER, WITH REFERENCE TO VOLUME AND PAGE DATES, SURVEYOR; EXACT DESCRIPTION OF MONUMENT PLACED OR FOUND, IF LOCATION COMPUTED, BY TAPED OR EDM TRAVERSE; LANDOWNER REMARKS, ETC.

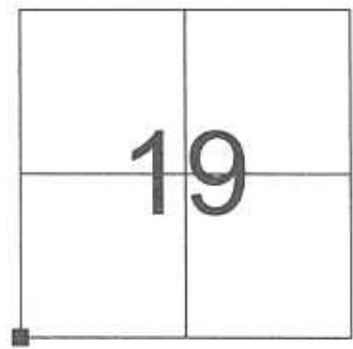

LOCATION

FOUND LUNDE MONUMENT AS PER TIE SHEET DATED 12/28/1998 BY CARL SANDSNES.

LEGEND

- = LUNDE MONUMENT FOUND
- = 5/8" DIAMETER IRON ROD FOUND
- () = PREVIOUSLY RECORDED AS



CERTIFIED CORRECT

Patrick J. Dederich
REGISTERED LAND SURVEYOR


DATE 6/13/2004

TIE SKETCH
(SHOW AT LEAST FOUR TIES)

NOT TO SCALE



BEARINGS ARE BASED ON THE JUNEAU COUNTY COORDINATE SYSTEM UNLESS OTHERWISE NOTED

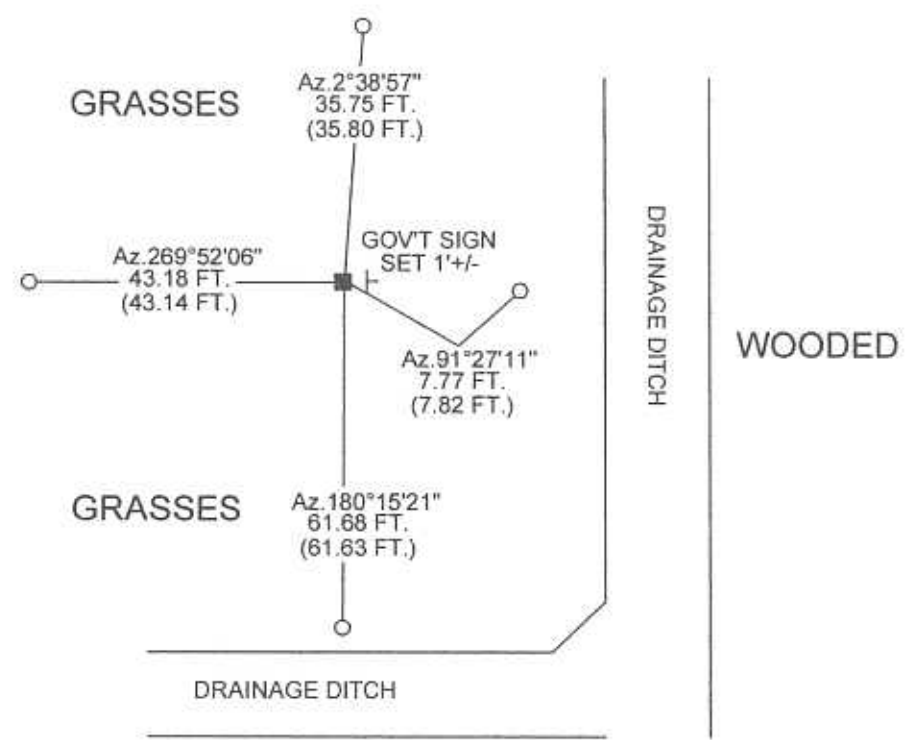

FOR VERNON COUNTY, WISCONSIN


Note: This form is intended and designed to fulfill all requirements of Wisconsin Administrative Code, Chapter AE-7.08, U.S. Public Land Survey Monument Record (3)(a)(b)(c)(d)(e)(f)(g)(h)(i). Use additional sheets if necessary.

(a) The Section corner common to Sections 24,25,20,29

Township(s) 14 North, Range(s) 1,2 East.

Vernon County Coordinates: N 190891.655


Datum: _____ E 854580.599

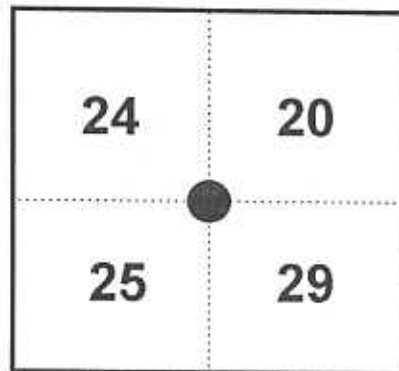

(b)(f)(h) Description of monument found at this corner and if it was accepted, state all evidence (material, testimonial, occupational, plats records, other monuments) used as a basis for accepting. If not accepted or nothing was found, state evidence used as basis for establishing location and what was set. If re-established through lost corner proportionate methods, indicate all monuments, distances and directions used.

1-05-98 Set Vernon County Monument by straight-line proportionate method between the East corner of Section 25, Township 14, Range 1 East and the East corner of Section 13, Township 14, Range 1 East.

(c)(d)(e) Plan view of corner with ties to at least four (4) witness monuments. If in disagreement with previously established corner, show the distances between the two corners and also indicate ties to disputed corner.

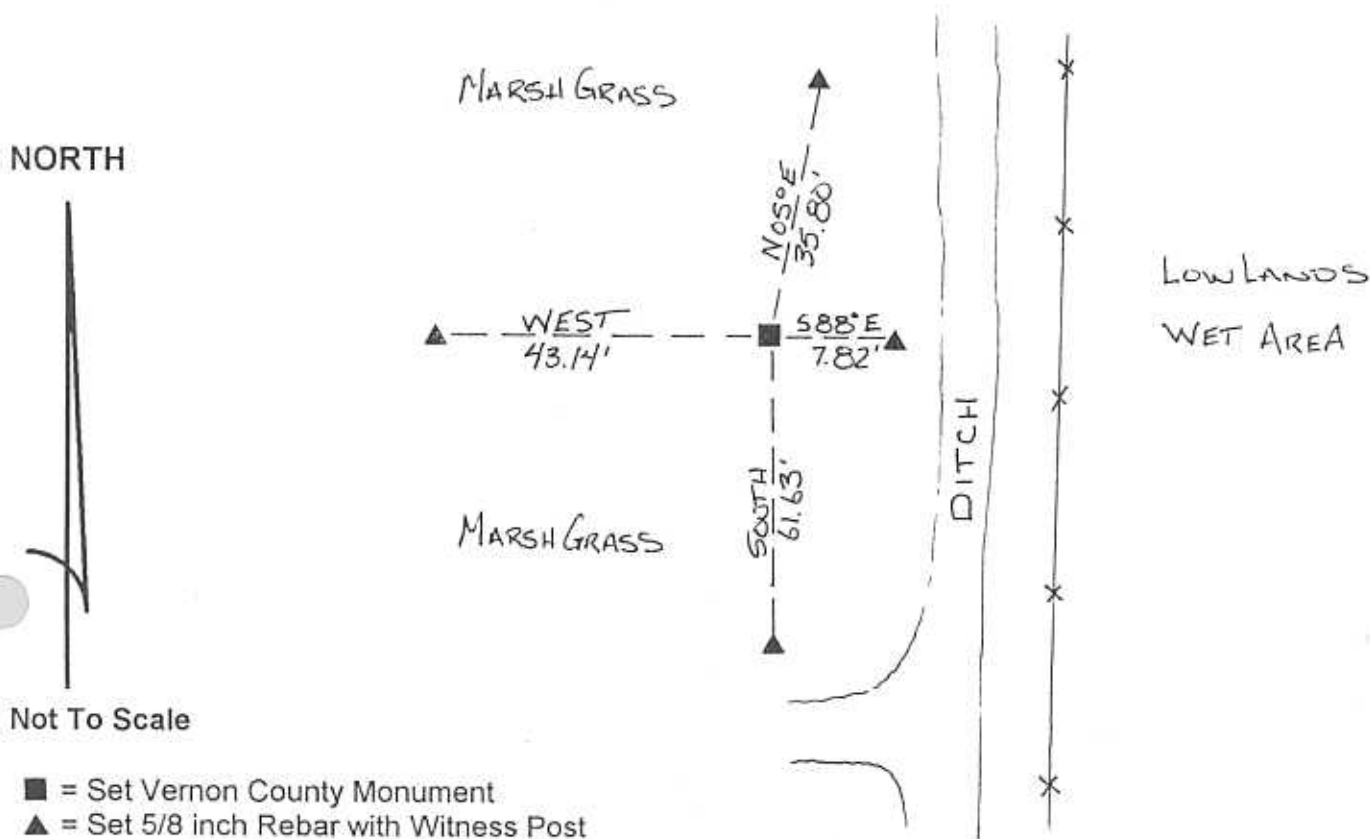

Not To Scale

(l) Certify that the corner location on this record was determined by me or under my direction and control and that this U.S. Public Land survey Monument Record is correct and complete to the best of my knowledge and belief.

[Handwritten Signature]
Signature

12/22/98
Date



Filed for record in Vernon County Surveyor's Office on _____ INDEX NO. _____