


VERNON COUNTY

CERTIFIED U.S. PUBLIC LAND SURVEY MONUMENT RECORD

INSTRUCTIONS: THIS RECORD SHALL SHOW THE LOCATION OF THE CORNER AND SHALL INCLUDE ALL OF THE FOLLOWING ELEMENTS (A-1)

(A) IDENTIFY THE CORNER BY REFERENCE TO THE U.S. PUBLIC LAND SURVEY SYSTEM
SOUTH QUARTER CORNER SECTION 25, T14N, R1E

- ⊕ = CORNER MONUMENT RESTORED - 2" iron pipe with brass cap Lunde Monument found
- WITNESSES TO CORNER LOCATION
- 1) SEAN M. WALSH
- 2)
- 3)

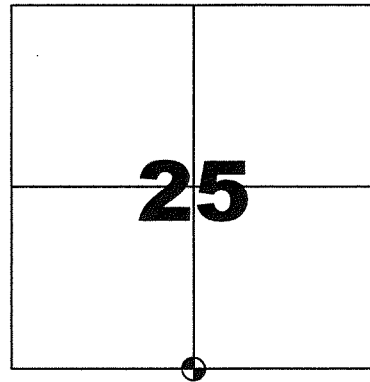


SOUTH QUARTER CORNER
SECTION 25, TOWN 14 NORTH, RANGE 1 EAST

BASIS OF BEARINGS AND COORDINATES:
 WISCRS VERNON, NAD 83(2011)

(C) IN THE PLAN VIEW DRAWING BELOW, PROVIDE REFERENCE TO AT LEAST 4 WITNESS MONUMENTS OR, IF THE LOCATION IS WITHIN A MUNICIPALITY, TO AT LEAST 2 WITNESS MONUMENTS. (WITNESS MONUMENTS SHALL BE MADE OF CONCRETE, NATURAL STONE, IRON OR OTHER EQUALLY DURABLE MATERIAL) DESCRIBE WITNESS MONUMENTS

(D) SHOW A PLAN VIEW DRAWING, DEPICTING THE RELEVANT MONUMENTS AND REFERENCE TIES, WHICH IS SUFFICIENTLY DETAILED TO ENABLE ACCURATE RELOCATION OF THE CORNER MONUMENT IF IT IS DISTURBED.

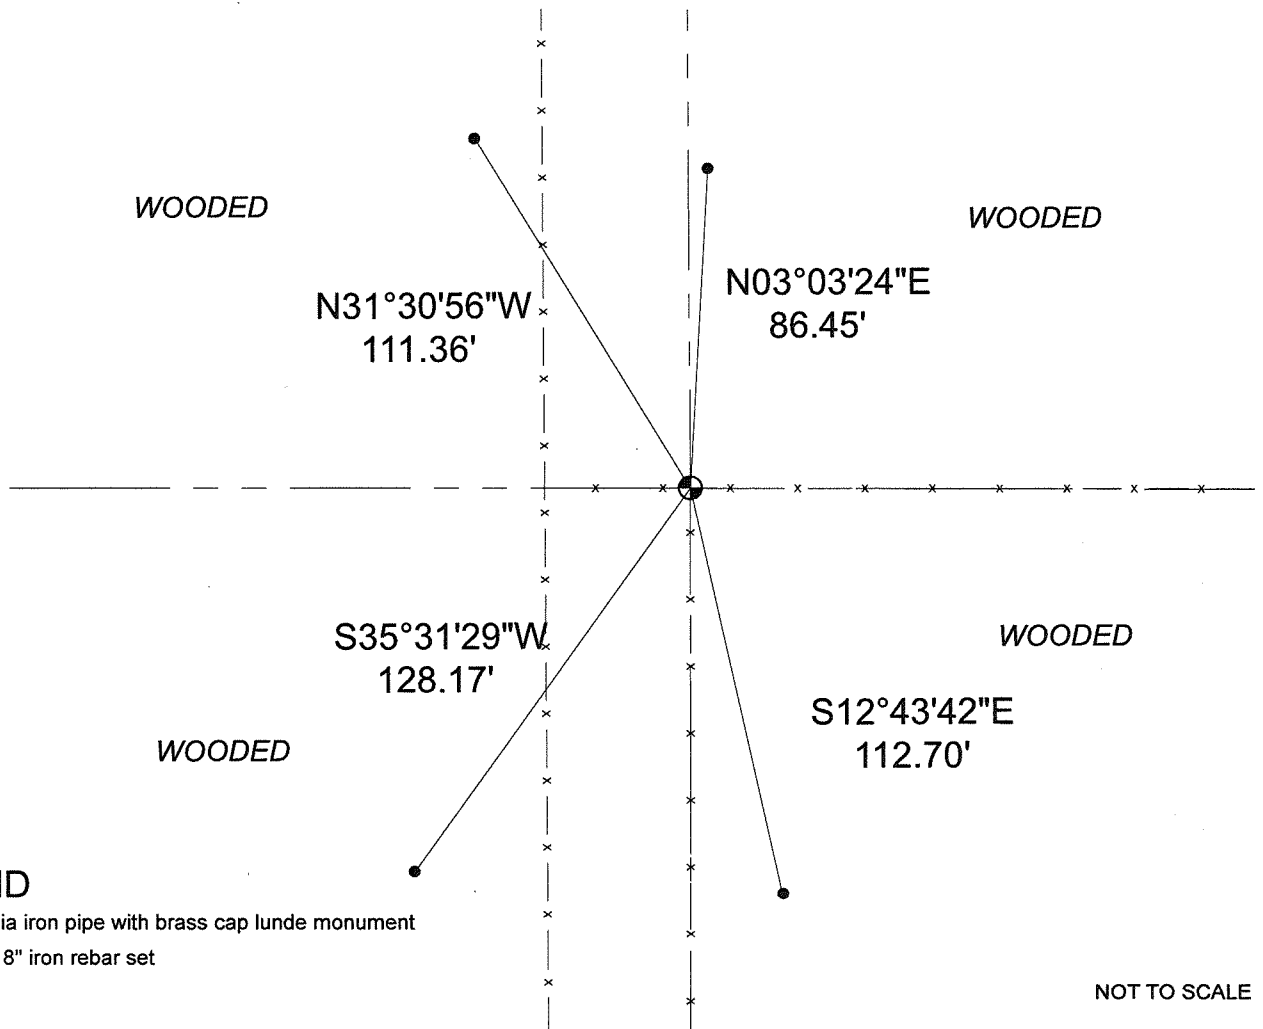

LEGEND

- ⊕ Found 2" dia iron pipe with brass cap lunde monument
- 3/4" dia x 18" iron rebar set

NOT TO SCALE

VERNON COUNTY
CERTIFIED U.S. PUBLIC LAND SURVEY MONUMENT RECORD

RECOVERY PROCEDURES:

(E) A DESCRIPTION OF ANY RECORD EVIDENCE, MONUMENT EVIDENCE, OCCUPATIONAL EVIDENCE, TESTIMONIAL EVIDENCE OR ANY OTHER MATERIAL EVIDENCE CONSIDERED BY THE SURVEYOR, AND WHETHER THE MONUMENT WAS FOUND OR PLACED;

CORNER HISTORY:

ORIGINAL GOV'T SURVEY, MARSH 1845

JAMES CARROLL 1998 FOUND SPIKE

1997 F.C CROOK SET CORNER FROM STERLING BLACK OAK WITNESS TREE AND MATCHING OCCUPATION. BLACK OAK TREE STILL PRESENT WITH MAGNETIC READING THAT MATCHES CROOK'S WITNESS SPIKE (OVERGROWN) LOCATION.

2009 G. FAUERBACH SECTION 25 PLAT OF SURVEY SHOWS CORNER LOCATION BUT DOES NOT IDENTIFY MONUMENT

I FOUND AND ACCEPTED THE LUNDE MONUMENT AS SET AND DOCUMENTED BY F.C. CROOK IN 1997. SPIKES IN WITNESS TREES ARE OVERGROWN. I SET 4 NEW 3/4" DIA IRON REBAR WITNESS MONUMENTS AS ILLUSTRATED TO PERPETUATE.

(F) WHETHER THE CORNER WAS RESTORED THROUGH ACCEPTANCE OF AN OBLITERATED EVIDENCE LOCATION OR A FOUND PERPETUATED LOCATION;

FOUND PERPETUATED LOCATION;

(G) WHETHER THE CORNER WAS REESTABLISHED THROUGH LOST-CORNER PROPORTIONATE METHODS;

IF SO, S HOW THE DIRECTIONS AND DISTANCES TO OTHER PUBLIC LAND SURVEY CORNERS WHICH WERE USED AS EVIDENCE OR USED FOR PROPORTIONING IN DETERMINING THE CORNER LOCATION;

SURVEYOR'S CERTIFICATE: CHAPTER 7.08 (3) (I)

THE UNDERSIGNED HEREBY CERTIFIES THAT THE U.S. PUBLIC LAND SURVEY MONUMENT RECORD SHOWN WAS DETERMINED BY THEM OR UNDER THEIR DIRECTION AND IS CORRECT AND COMPLETE TO THE BEST OF THEIR KNOWLEDGE AND BELIEF.



Sean M. Walsh 8/31/22

DATE CERTIFIED

DEC 17 1997

CERTIFIED LAND CORNER

STATE OF WISCONSIN)
COUNTY OF VERNON) S.S.

CERTIFICATE


I, F. CURTIS CROOK, do hereby certify that on the 22nd day of NOVEMBER 1997, I found (evidence) ~~(no evidence)~~ of the N 1/4 corner of SECTION 36, T 14 N, R 1 E, Fourth Principal Meridian, and I re-established said corner according to the Wisconsin Statutes as shown and described hereon.

Dated this 15th day of Dec 1997

F. CURTIS CROOK R.L.S. S-1292



Seal

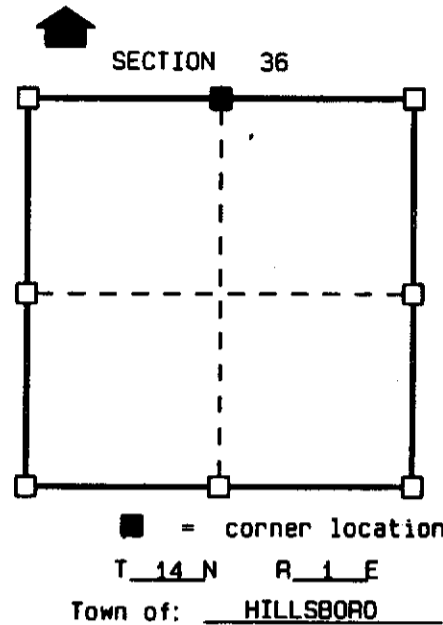

History of original corner establishment:

ORIGINAL CORNER ESTABLISHED BY JAMES M. MARSH IN 1845. IN 1894, C.M. STERLING MADE ONE NEW TIE FOR THE CORNER & MADE REFERENCE TO A WITNESS POST. JAMES M. CARROLL REFERS TO A SPIKE NAIL FOUND AT CORNER ON C.S.M. V.1, P.208.

Description of corner evidence found:


FOUND STERLING'S TIE (R.A. 10" BLACK OAK) WHICH IS NOW A 40" BLACK OAK. DID NOT FIND SPIKE NAIL MENTIONED ABOVE. DETERMINED CORNER LOCATION USING THE BLACK OAK. SAID LOCATION MATCHED THE OCCUPIED CORNER. THE DISTANCE FROM THE NW CORNER OF SECTION 36 TO THE N 1/4 CORNER AS DETERMINED ABOVE MATCHES THAT MEASURED BY STERLING WITHIN 0.3'±. SET VERNON COUNTY MONUMENT AND MADE TIES AS SHOWN BELOW.

Description of corner and witness monuments, references and accessories used to perpetuate the original or re-established location of this corner:

Witnesses to corner location:

F. CURTIS CROOK
CHAD CROOK
WADE CROOK

Sketch:

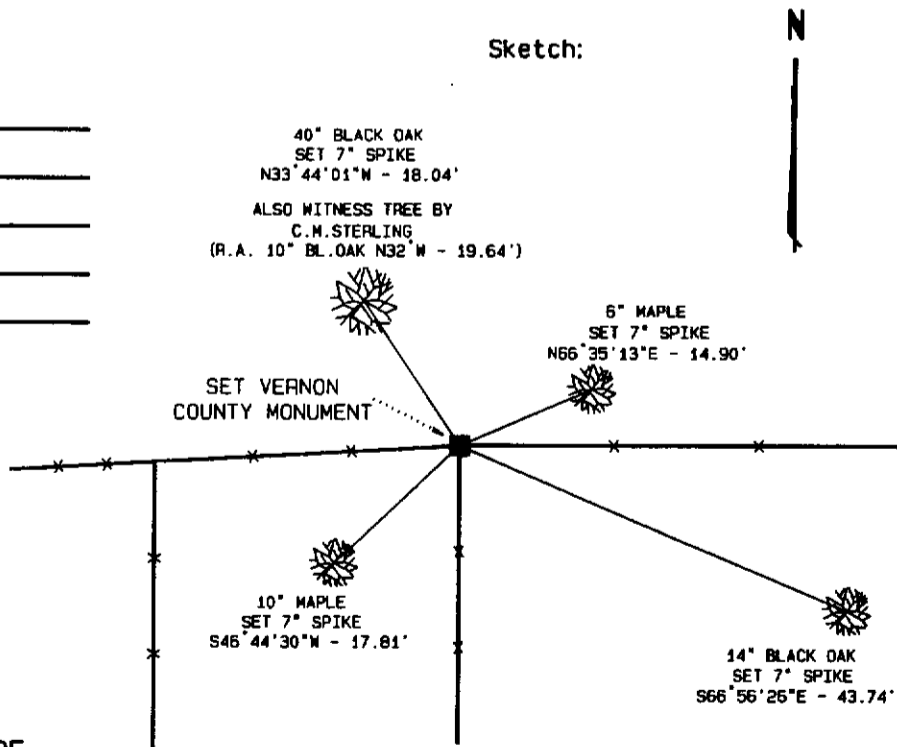

NOTES:
DRAWING IS NOT TO SCALE.
BEARINGS ARE REFERENCED TO PROJECT.
VERNON COUNTY MONUMENTS ARE LUNDE MONUMENTS.
SET SURVEY MARKER SIGN NEAR MONUMENT.

(THIS CORNER SET AS PART OF VERNON COUNTY'S 1997 REMONUMENTATION PROJECT.)


VERNON COUNTY COORDINATES

North (Y)	East (X)
185542.086	851942.390

49

DATA SHEET

SECTION 36, T14N, R1E
TOWN OF HILLSBORO, VERNON COUNTY

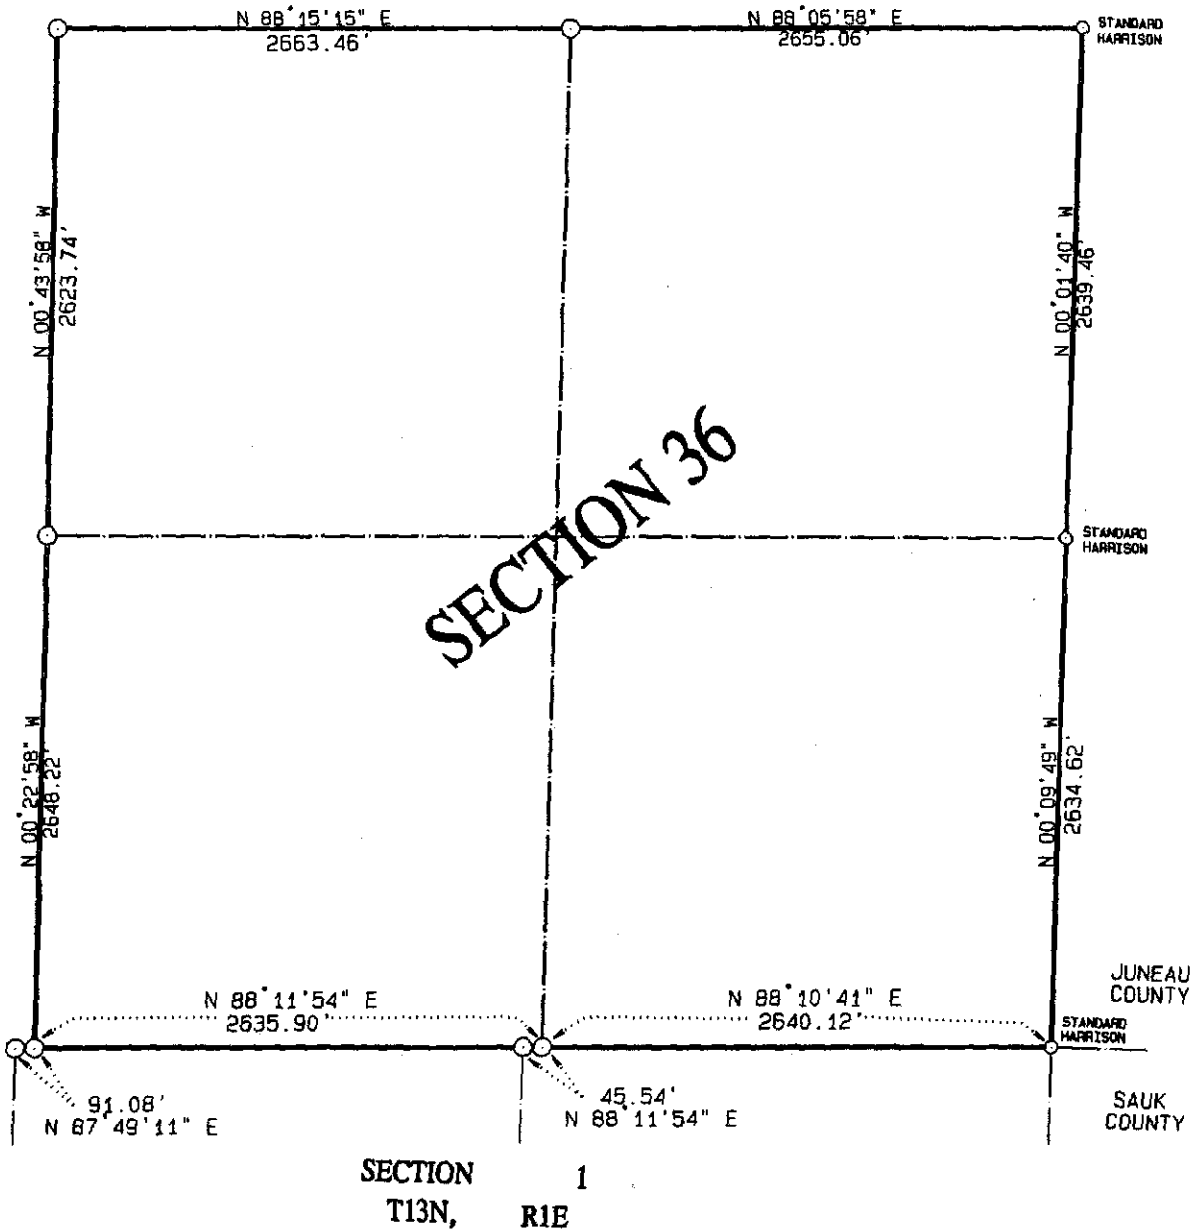

NOTE: ALL CORNERS (WITH EXCEPTION OF THOSE NOTED)
ARE VERNON COUNTY MONUMENTS.

THIS DATA SHEET PREPARED AS PART OF
VERNON COUNTY'S 1997 REMONUMENTATION PROJECT.