


Section Summary and Index

9 - 14 - 2W
 Section Town Range

VERNON Co. TOWN OF WHITESTOWN

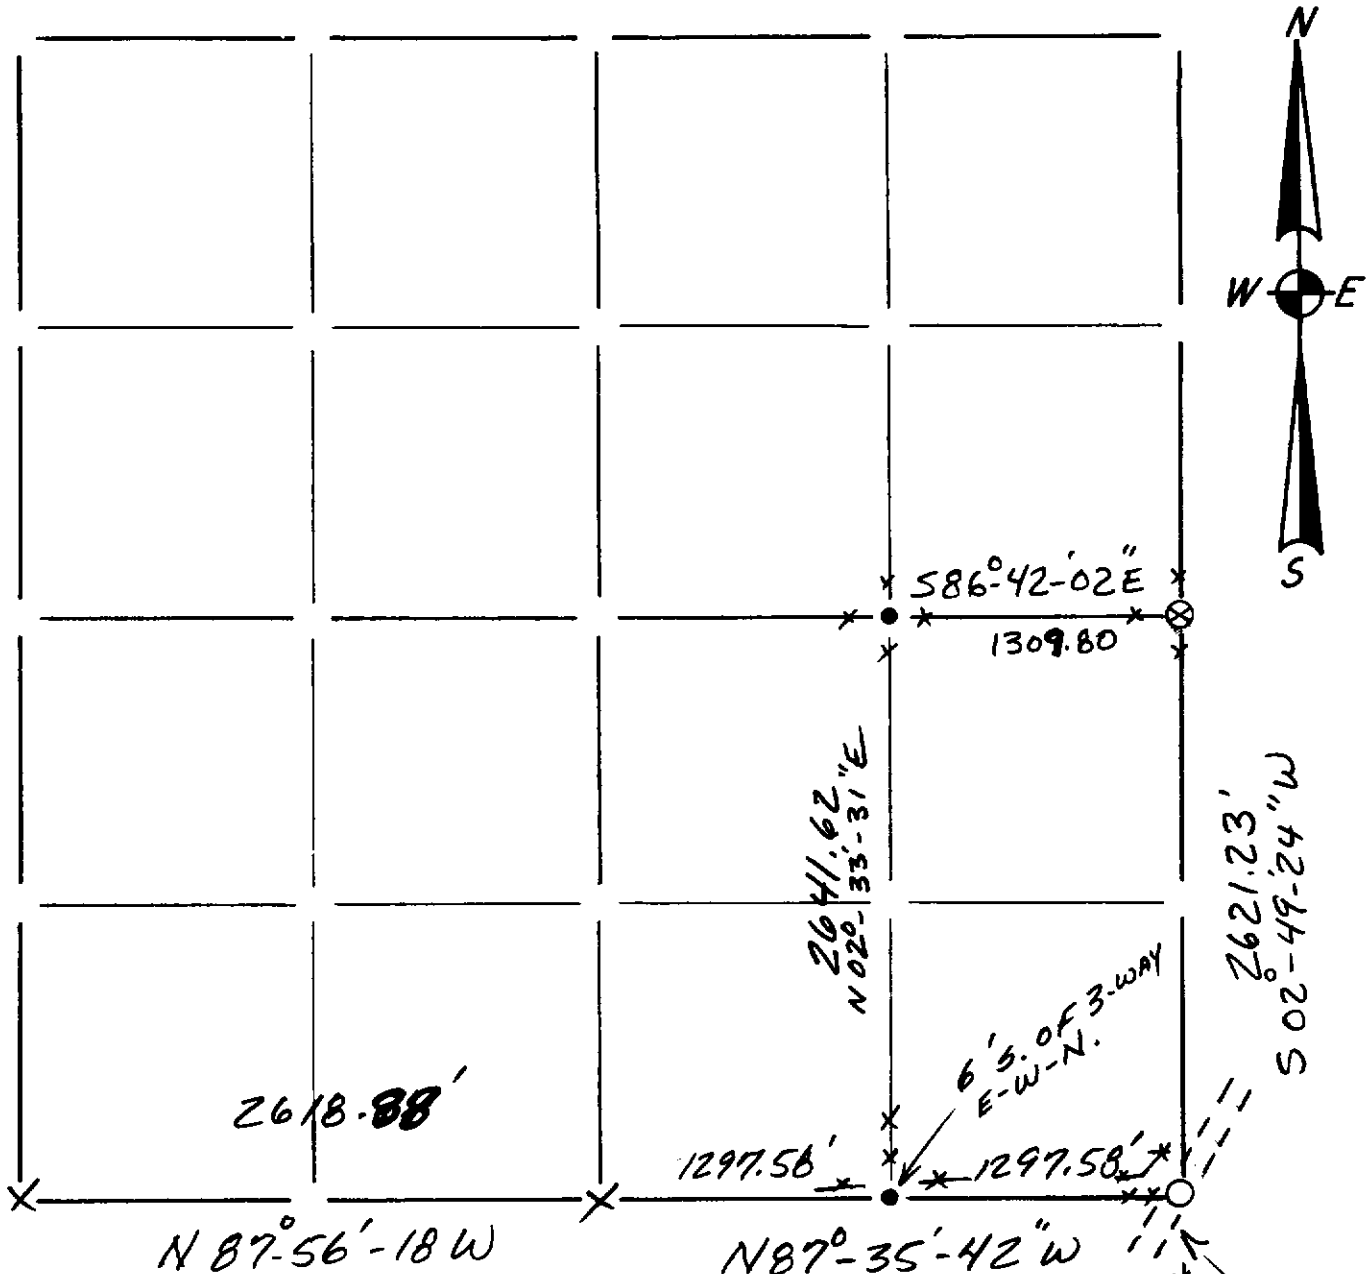

LEGEND

- ⊕ - Harrison cast iron monument.
- - Stone or concrete monument.
- - Other 2" GALV. SET
- ⊗ 1966 CORP. OF ENGR. 1" ID IP W/ BRASS CAP 9" ↑
- 1-1/4" ID SET 8" ↑ @ F.C.
- X 1-1/2" PIPE

SE OF GILLEN HILL RD
 (GRAVEL) AKA. DOG RD.



(1A)