


**U. S. PUBLIC LAND SURVEY MONUMENT RECORD**

SECTION 36 T 15 N, R 2 W, TOWN OF SHELBY

**LA CROSSE COUNTY**

*N<sup>1</sup>/<sub>4</sub> cor. 1-14-7W?*

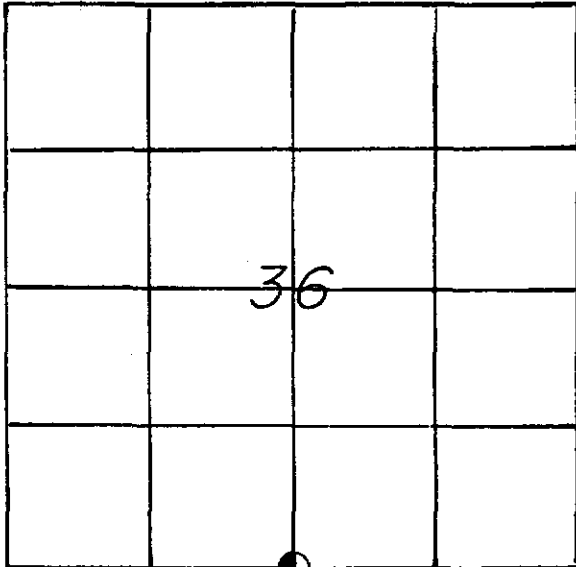

LOCATION OF LANDMARK

CREW:  
BILL JUNG  
PERRY DAHL

DATE: 8-15-86

<b>WISCONSIN COORDINATE SYSTEM</b>
North
East
Theta Angle
Horiz. Order
Vert. Order
<b>TYPE OF LANDMARK</b>
BRASS CAPPED LUNDE MARKER
<b>BEARINGS ARE REFERENCED TO</b>
Assumed

Describe any record evidence, monument evidence, testimonial evidence or any other material evidence you considered and whether the monument was found or restored through acceptance of an obliterated evidence location.

I set the corner on line with the SW corner and the S1/16SW corner, and at a distance from said S1/16SW corner equal to the distance between the SW and S1/16SW. I feel that this location fits the old Town Line and other evidence found very well. This corner was lost. I could find no evidence of it. I set a brass capped Lunde marker at the corner.

Describe or show any material discrepancy between the location of the restored corner and that of the corner previously restored or reestablished.

None known.

