Township No. 11 N, Range No. 6 West 4th Mer

Received with the Surv. Genls letter of the 22 March 1844

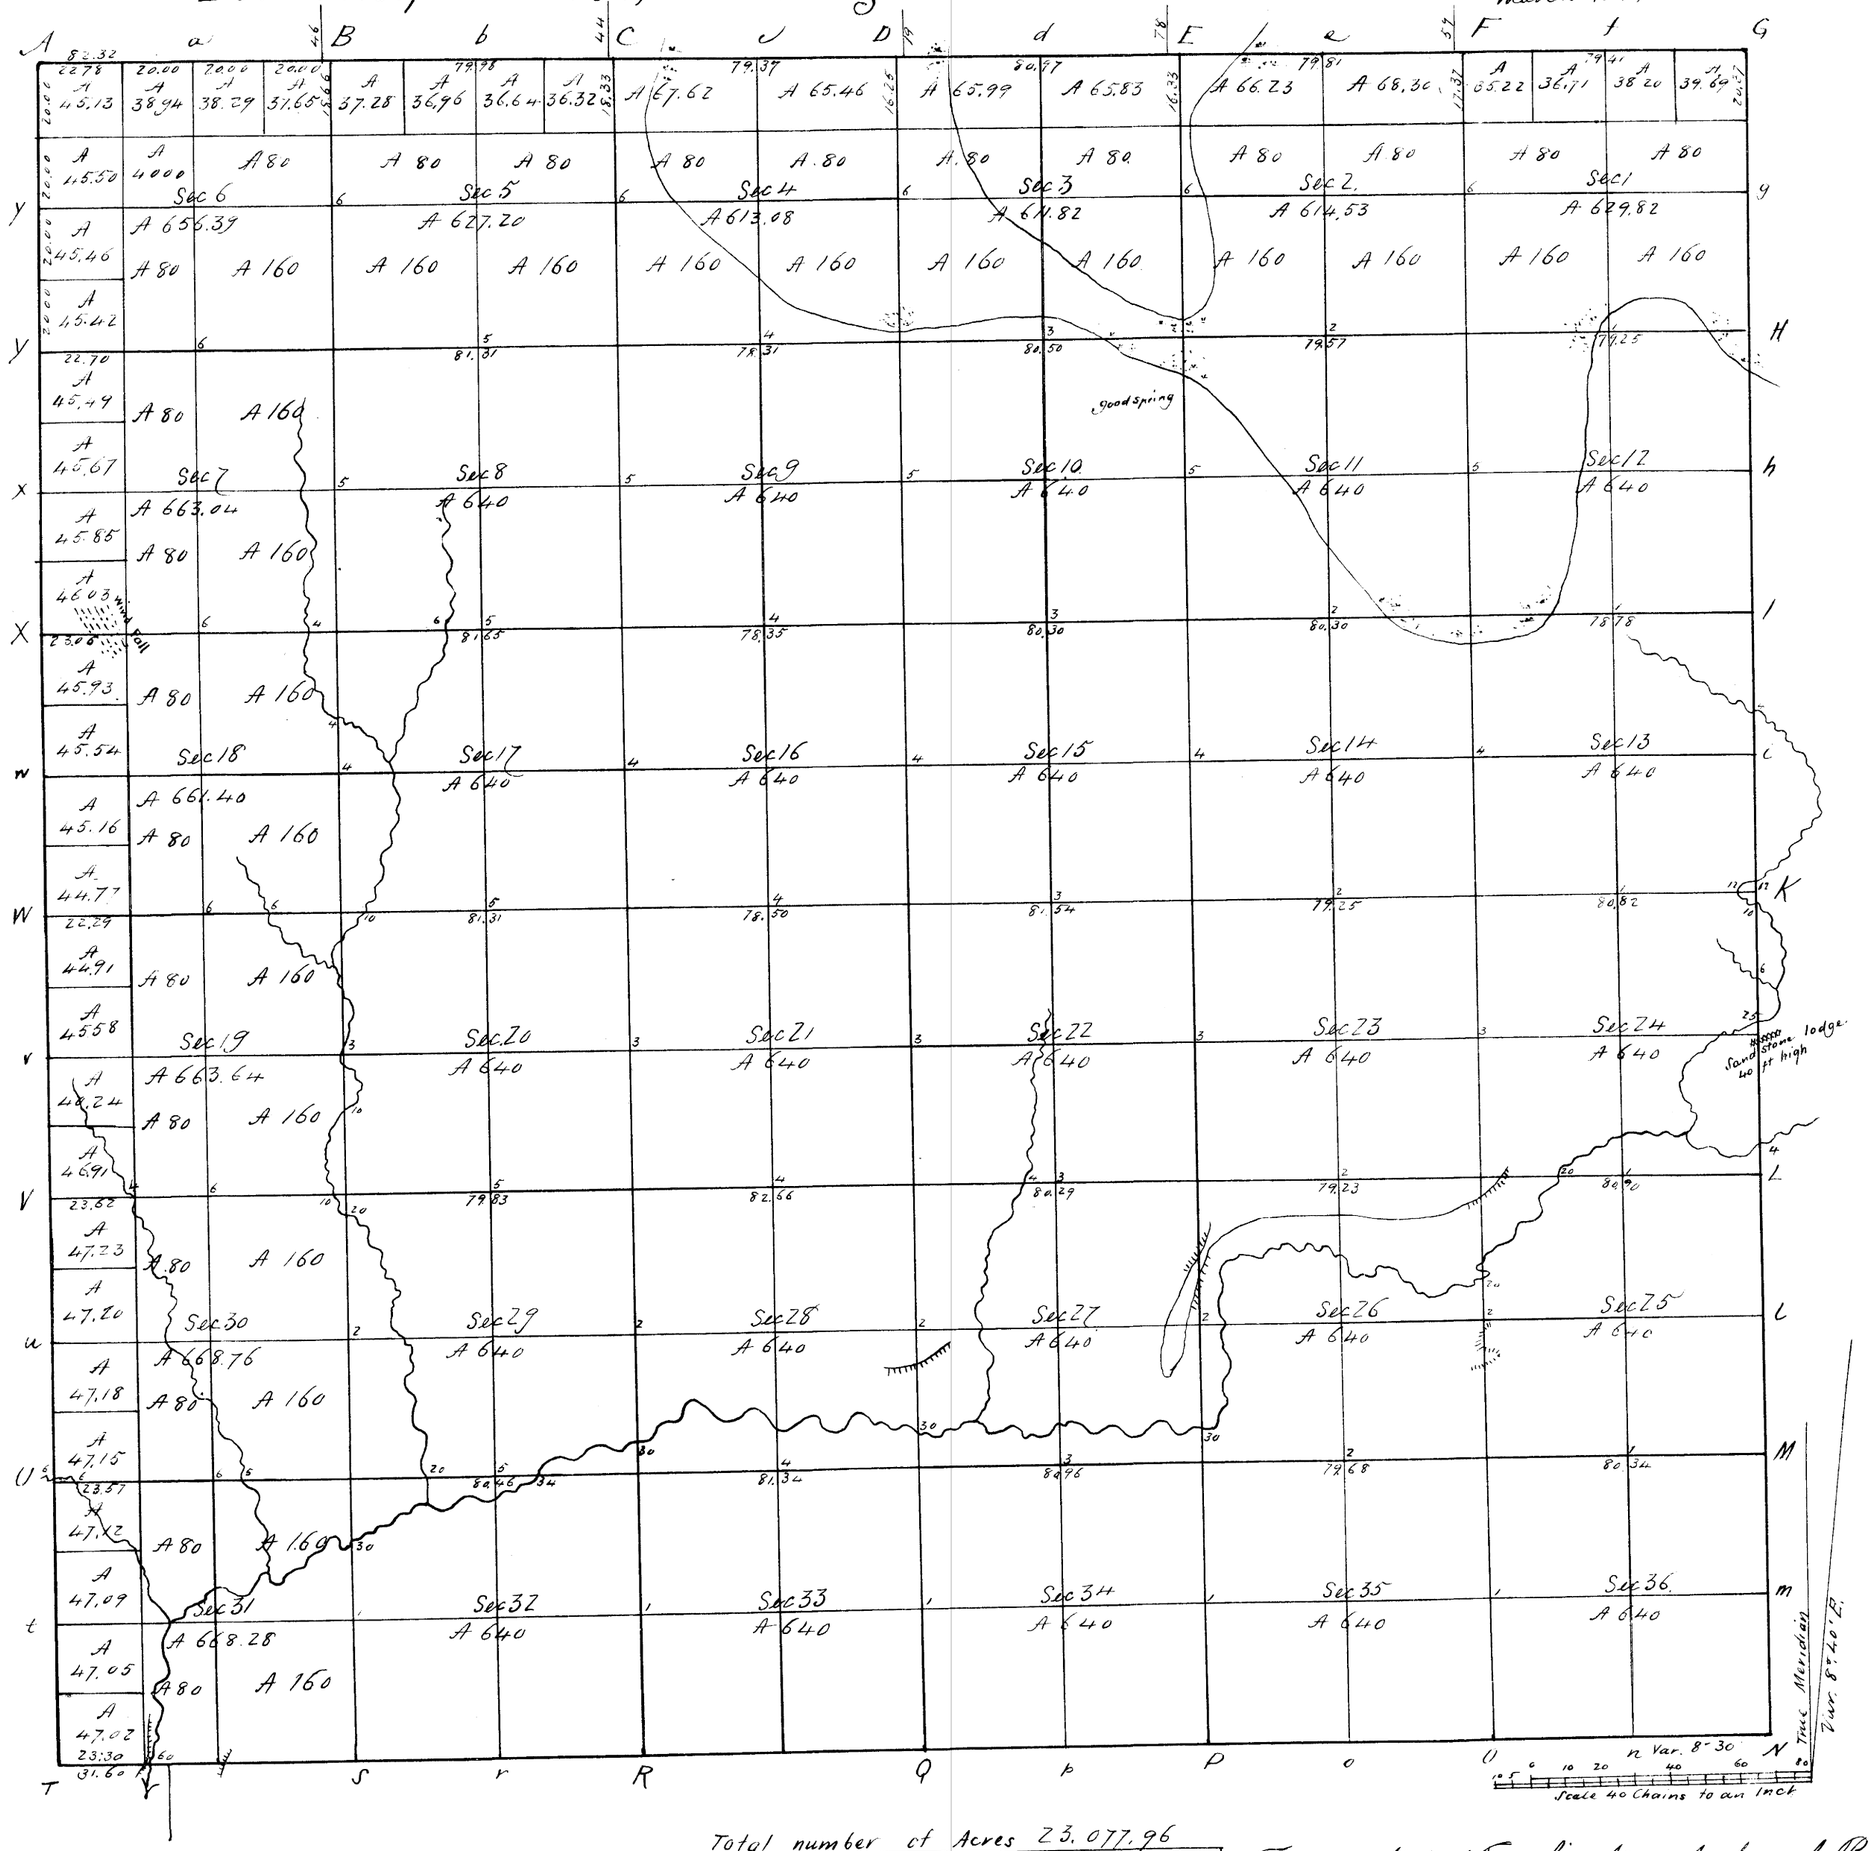

Total number of Acres 23,077.96

Surveys Designated	By Whom Surveyed	Date of Contract	Amount of Surveys	When Surveyed	When put for and ent. in the Surr. Gen'l's acct.
Township lines	Wm A. Burt	Oct 24. 1839	M. chs lks 24.. 06.. 19	1st qr 1840	1st qr 1841
Subdivisions	A. L. Haven	May 23 1843	60 02 18	3rd qr 1843	4th qr 1843

The above Map of Township No 11 North of Range No 6 West 4th Principal Meridian Wisconsin Territory is strictly conformable to the field notes of the Survey thereof on file in this Office which have been examined and approved

Surveyor Generals Office
Dubuque Dec 27, 1843

James Wilson
Surr. Genl